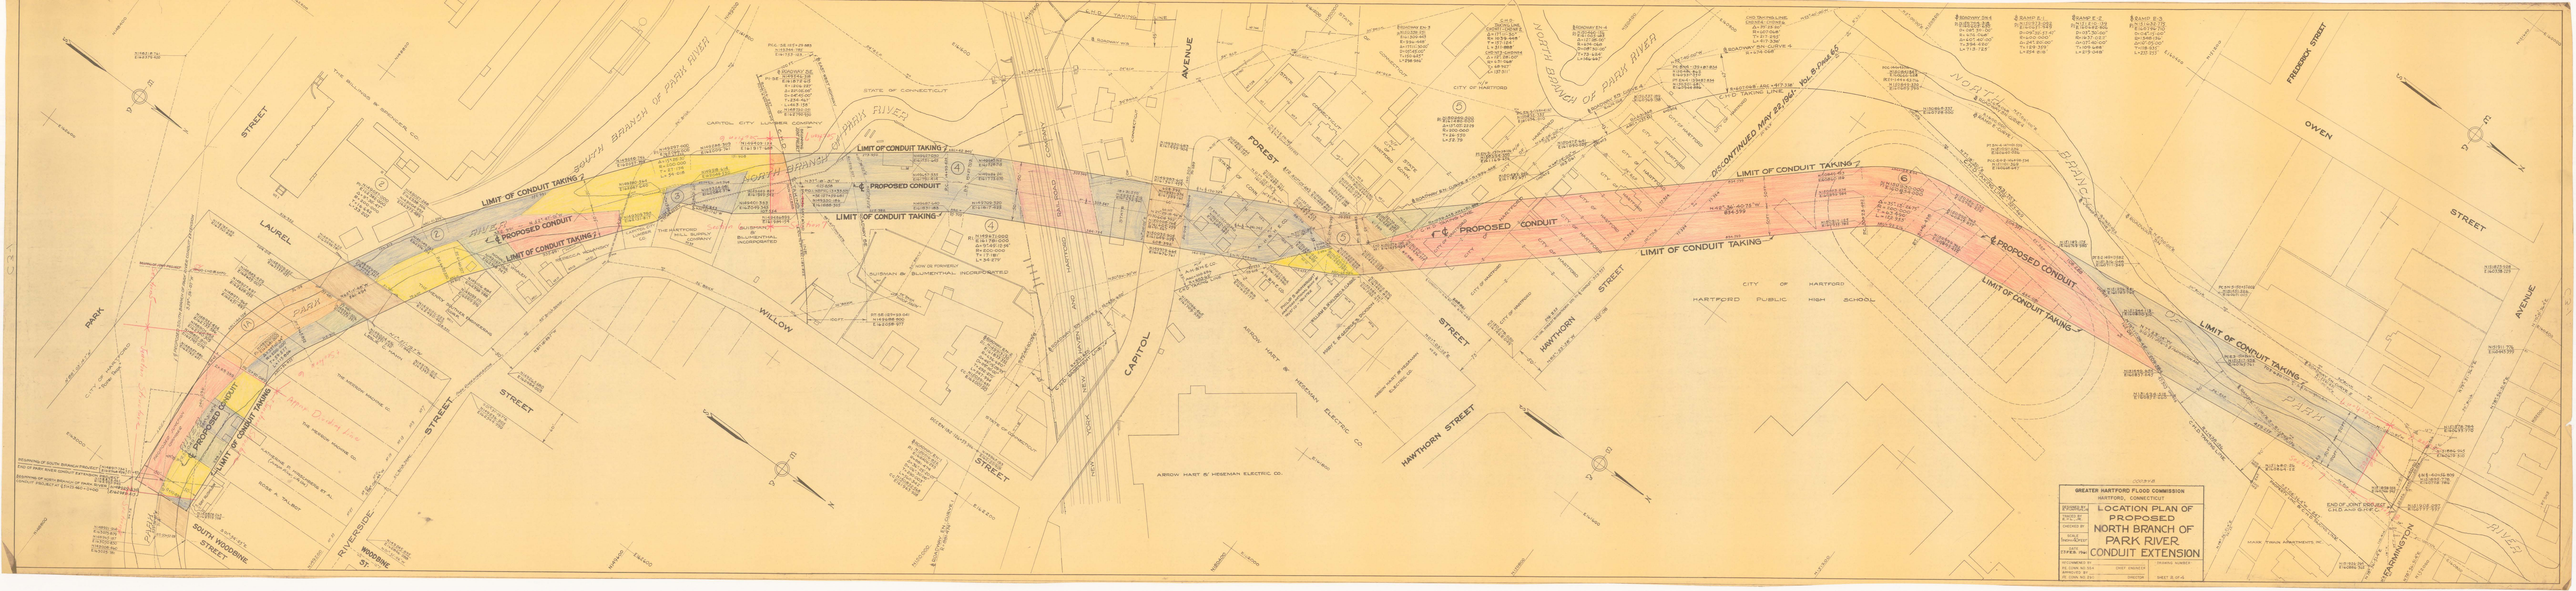
GREATER HARTFORD FLOOD COMMISSION
HARTFORD, CONNECTICUT
LOCATION PLAN OF
PROPOSED
NORTH BRANCH OF
PARK RIVER
CONDUIT EXTENSION
SHEET 5 OF 6
LIMIT OF CONDUIT TAKING
PROPOSED CONDUIT
SOUTH BRANCH OF PARK RIVER
NORTH BRANCH OF PARK RIVER
PARK RIVER
CAPITOL AVENUE
FOREST STREET
HAWTHORN STREET
WILLOW STREET
LAUREL STREET
OWEN STREET
FREDERICK STREET
RIVERSIDE STREET
CITY OF HARTFORD
HARTFORD PUBLIC HIGH SCHOOL
STATE OF CONNECTICUT
CAPITOL CITY LUMBER COMPANY
THE HARTFORD WALL SUPPLY COMPANY
BLUMENTHAL INCORPORATED
SUSMAN & BLUMENTHAL INCORPORATED
ARROW HART & HEGEMAN ELECTRIC CO.
THE WILLIAMS & WHITLOCK CO.
THE HARTFORD WALL SUPPLY COMPANY
MAJOR TOWN APARTMENTS INC.
END OF JOINT EDGE OF S.H.D. AND G.H.F.C.
BEGINNING OF SOUTH BRANCH PROJECT
END OF NORTH BRANCH PROJECT
BEGINNING OF NORTH BRANCH PROJECT
END OF SOUTH BRANCH PROJECT