


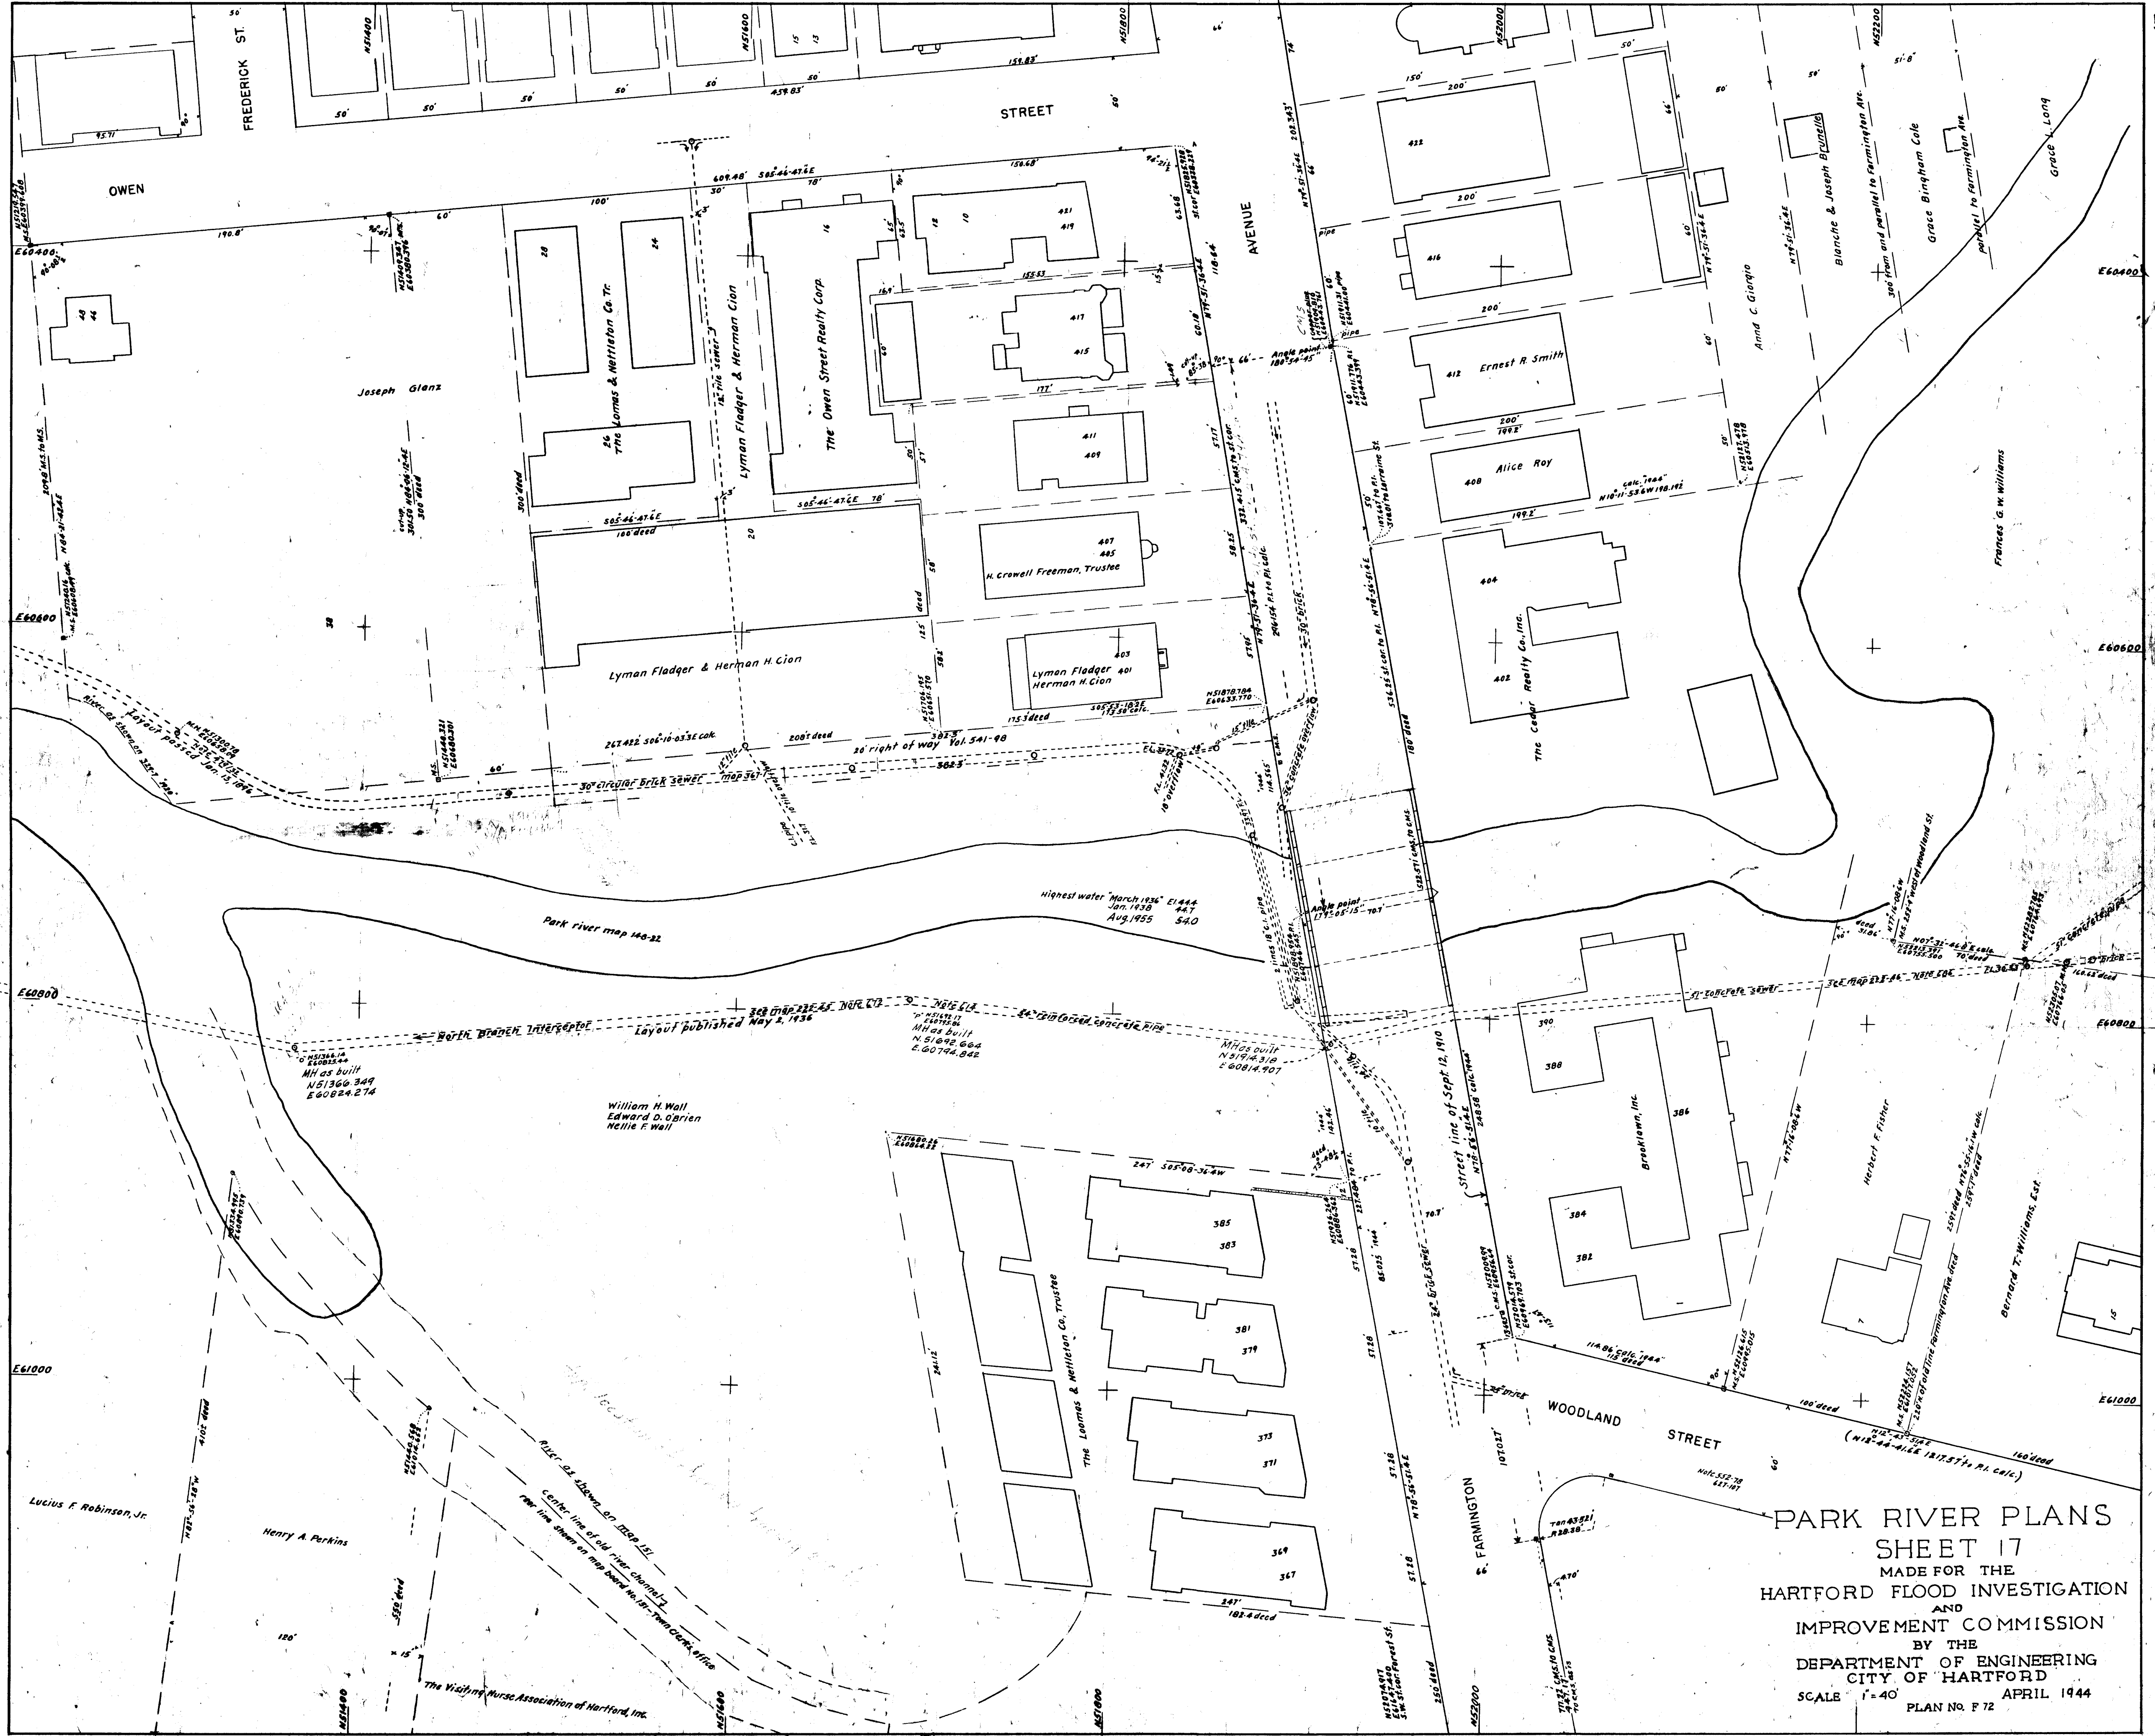

PARK RIVER PLANS
SHEET 17
MADE FOR THE
HARTFORD FLOOD INVESTIGATION
AND
IMPROVEMENT COMMISSION
BY THE
DEPARTMENT OF ENGINEERING
CITY OF HARTFORD
SCALE 1"=40' APRIL 1944
PLAN No. F 72

Corrected to January, 1956