


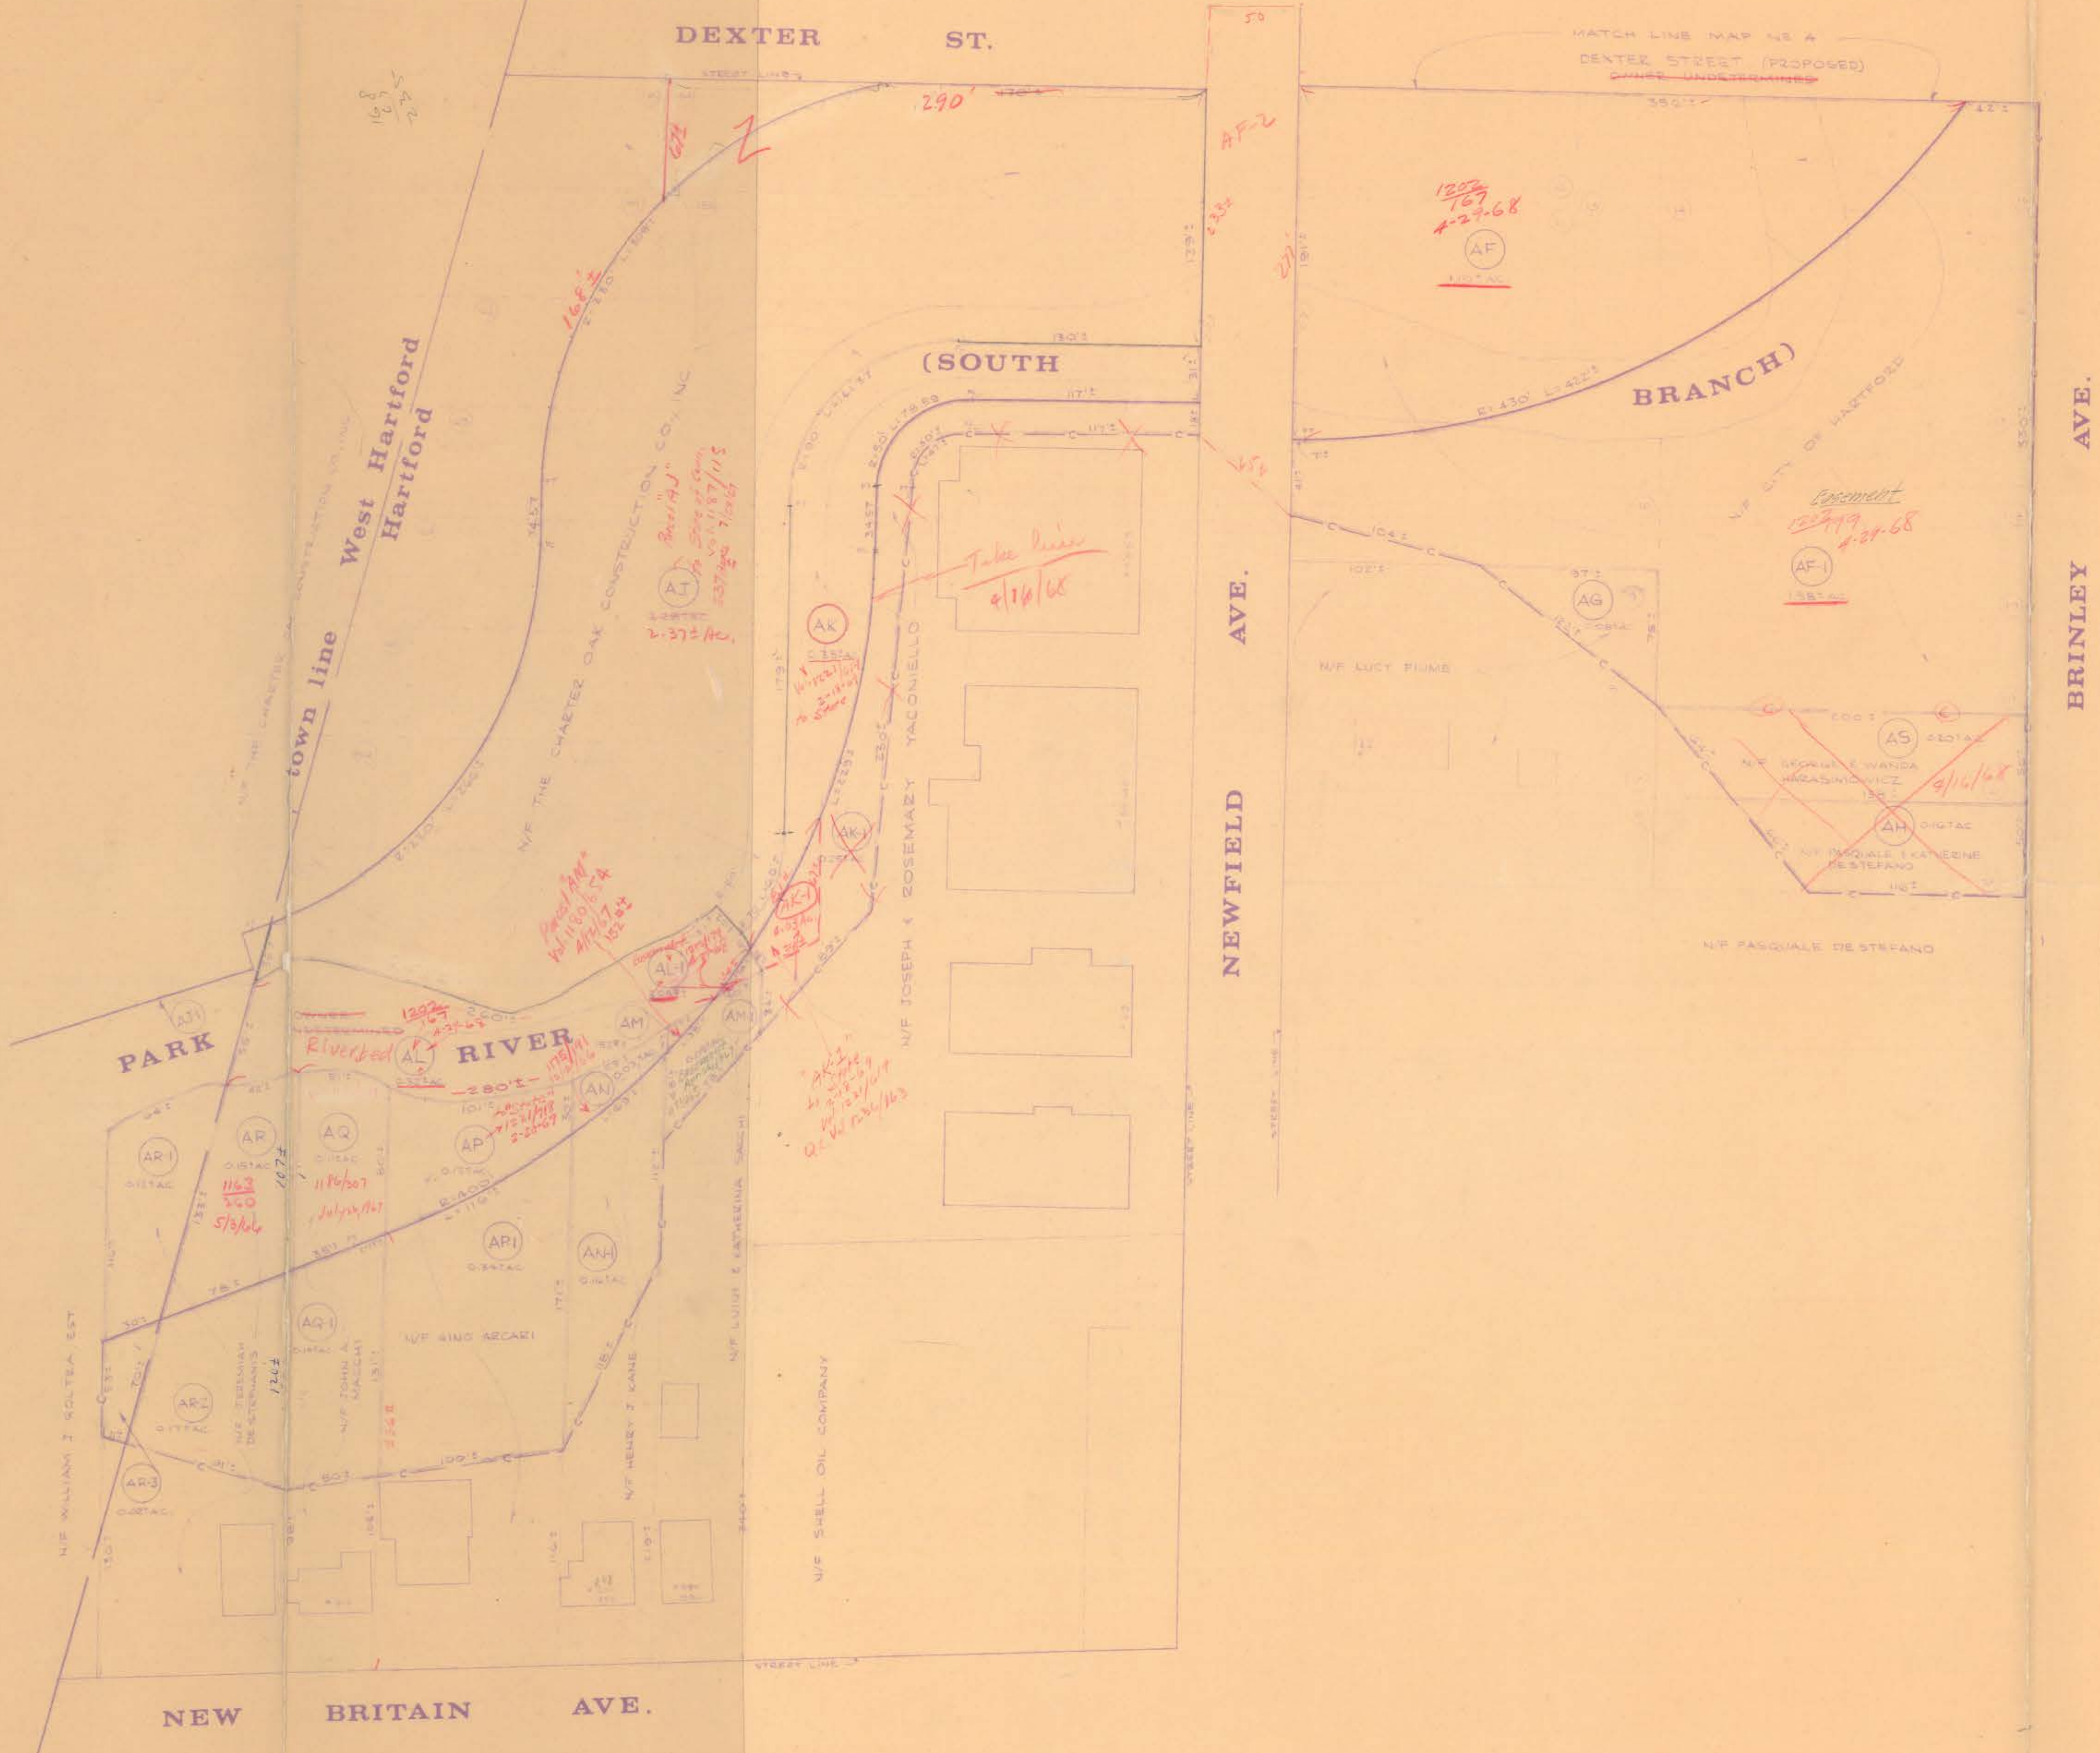

PARCEL	OWNER	ACRES
AF	N/F CITY OF HARTFORD	
AF-1	N/F " "	
AH	N/F PASQUALE DE STEFANO	
AJ	N/F THE CHARTER OAK CONSTRUCTION CO., INC.	2.372 Ac.
AK	N/F JOSEPH & ROSEMARY YACONIELLO	
AK-1	N/F " "	
AL	N/F " "	0.032 Ac.
AL-1	N/F " "	
AM	N/F LUIGI & KATHERINA SASSI	
AM-1	N/F " "	
AN	N/F HENRY J. KANE	
AN-1	N/F " "	
AP	N/F GINO ARZARI	
AP-1	N/F " "	
AQ	N/F JOHN A. MASCALI	
AQ-1	N/F " "	
AR	N/F JEREMIAH DE STEFANO	
AR-1	N/F " "	
AR-2	N/F " "	
AR-3	N/F " "	

out Apr. 16, 1968

RECEIVED
FEB 2 1965
DEPARTMENT OF
ENGINEERING

MAP OF LAND RIGHTS REQUIRED BY
THE STATE OF CONNECTICUT
FOR THE
PARK RIVER (SOUTH BRANCH)
STREAM CHANNEL IMPROVEMENT
SOUTH BRANCH OF THE PARK RIVER
WATERSHED PROGRAM
HARTFORD, CONN.

SCALE 1" = 50'
MAP NO. 5

MARCH, 1964

MORTON S. FINE & ASSOC.
BLOOMFIELD, CONN.
I HEREBY CERTIFY THAT THIS MAP
IS SUBSTANTIALLY CORRECT AND
IN ACCORDANCE WITH CLASS D
OR CODED CONN. TECH. COUNCIL, INC.