


PARCEL	OWNER	AREA
A-4	NIF THE HOUSING AUTHORITY OF THE CITY OF HARTFORD	4.42 AC

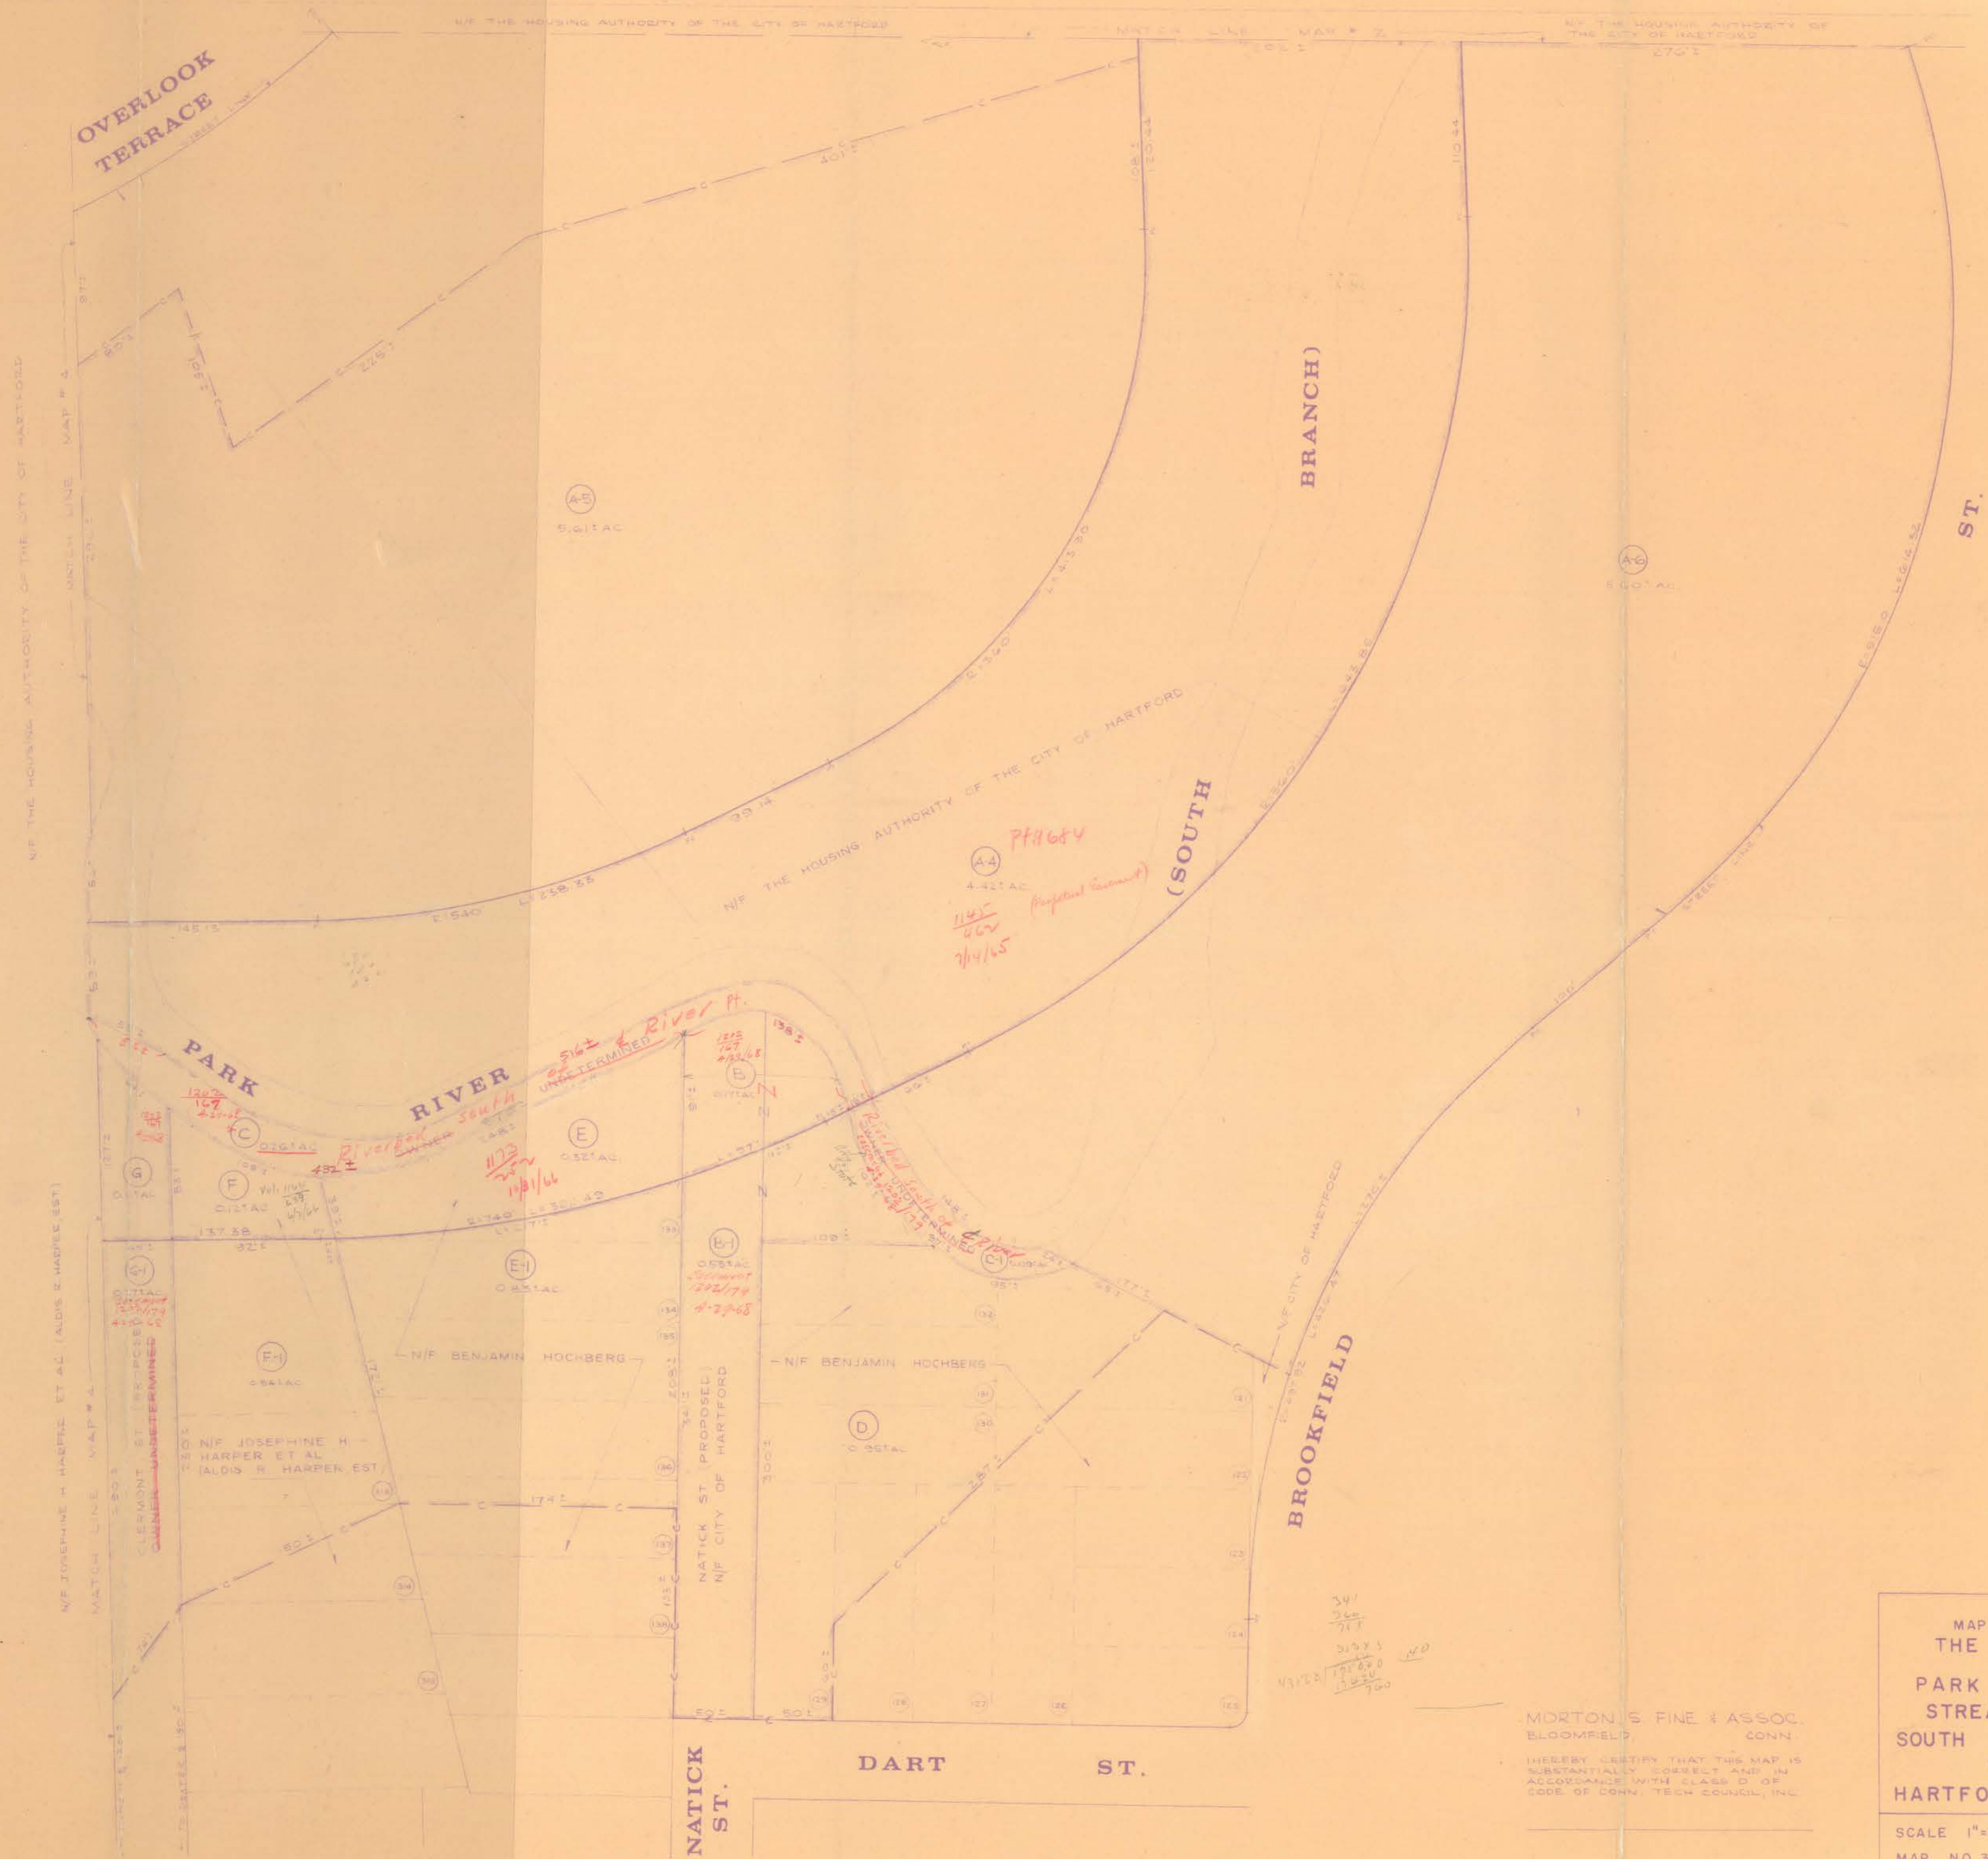

RECEIVED
FEB 2 1965
DEPARTMENT OF
ENGINEERING

MAP OF LAND RIGHTS REQUIRED BY
THE STATE OF CONNECTICUT
FOR THE
PARK RIVER (SOUTH BRANCH)
STREAM CHANNEL IMPROVEMENT
SOUTH BRANCH OF THE PARK RIVER
WATERSHED PROGRAM
HARTFORD, CONN.

SCALE 1"=50'
MAP NO.3

MARCH, 1964