


15914

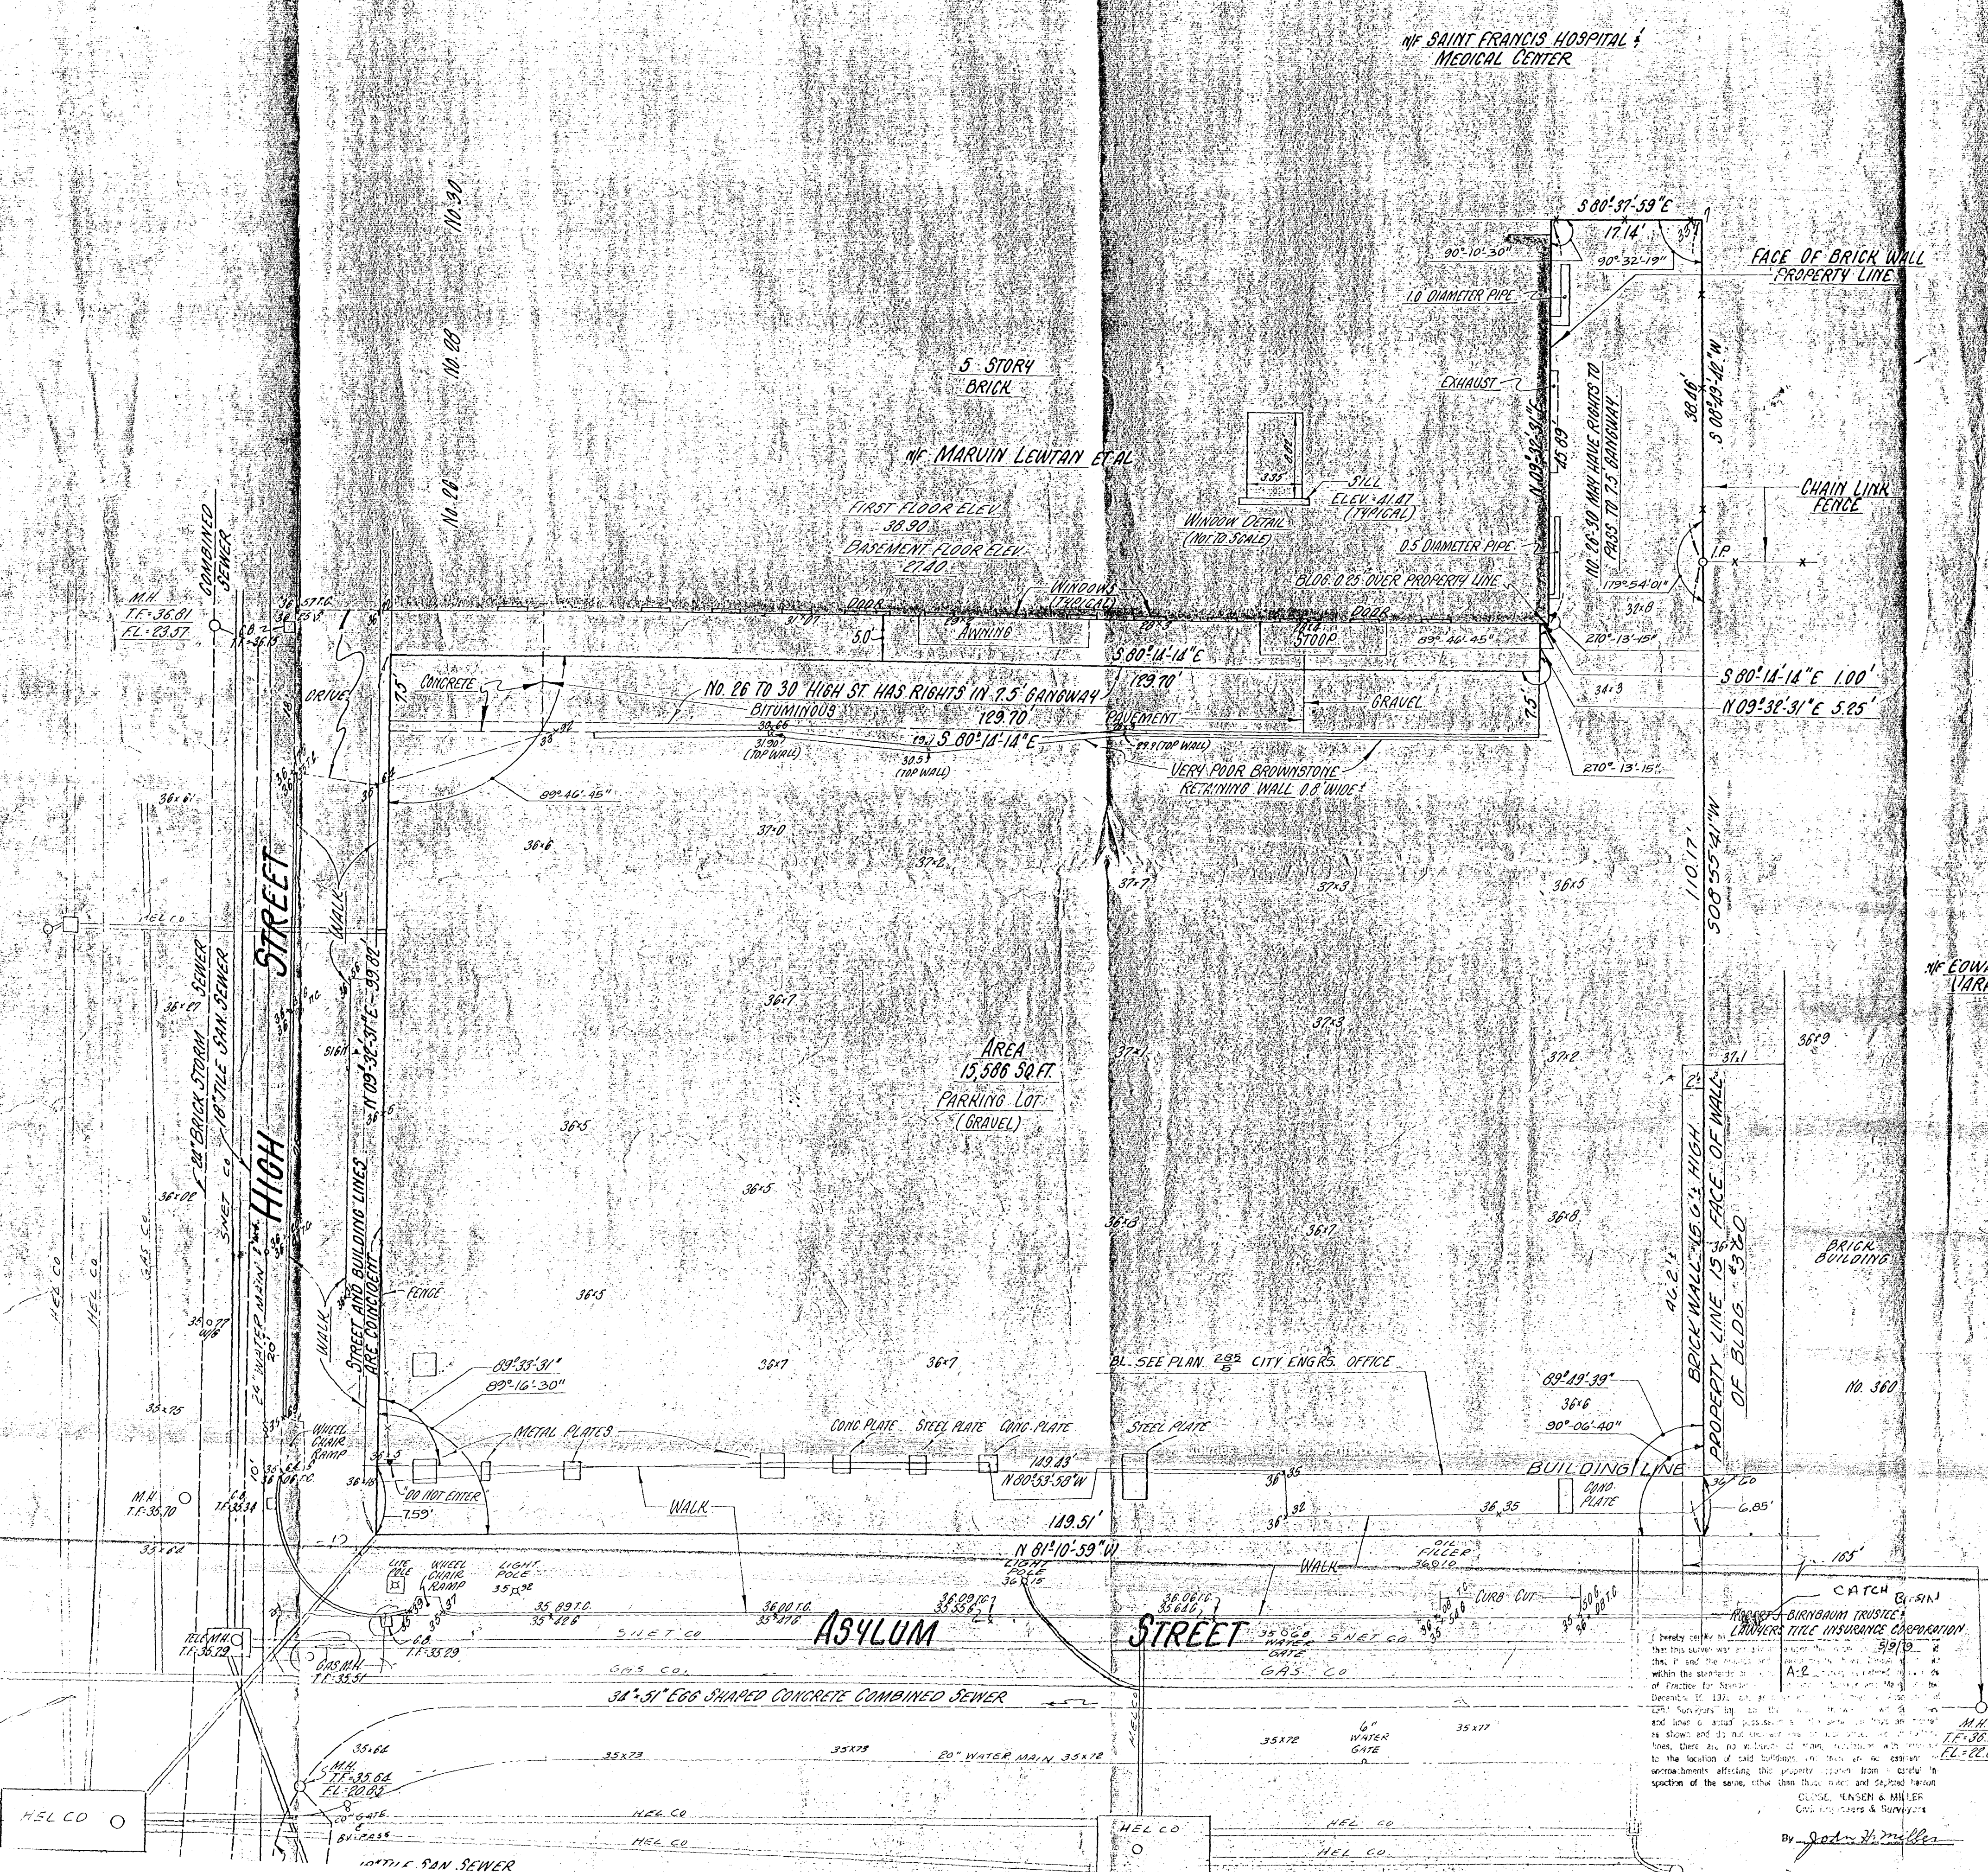

The location of the underground utilities shown on this plan have been obtained from the best available sources. The actual location of these utilities should be verified in the field by the contractor.

NOV 19 1980  
HARTFORD, CONN.

|   |                                                                                        |
|---|----------------------------------------------------------------------------------------|
| <b>CLOSE, JENSEN &amp; MILLER</b><br>CONSULTING ENGINEERS, LAND PLANNERS & SURVEYORS<br>449 SILAS DEANE HIGHWAY WETHERSFIELD, CONNECTICUT |                                                                                        |
| DESIGNED <b>R.B.B.</b>   |                                                                                        |
| DRAWN <b>J.H.M.</b>   |                                                                                        |
| CHECKED <b>J.H.M.</b>   |                                                                                        |
| DATE <b>MAY 1979</b>   |                                                                                        |
| SCALE <b>1" = 10'</b>   |                                                                                        |
| SHEET <b>1 OF 1</b>   |                                                                                        |
| PROPERTY OF<br><b>ROBERT J. BIRNBAUM</b><br>TRUSTEE<br><b>364-376 ASYLUM STREET</b><br><b>HARTFORD, CONNECTICUT</b>                       |                                                                                        |
| REVISIONS   | 1. 5/19/79 ADDED WALL DIMENSIONS 11/10/80<br>2. 11/15/79<br>3. 11/15/79<br>4. 11/17/80 |
| 5. ADDITIONAL B.L. DIMENSIONS 11/10/80<br>6. 10000 REV UTILITIES ADDED WINDOW SILL ELEV<br>TIES TO B.L. AND INTERNAL ANGLES               |                                                                                        |

14-1051