


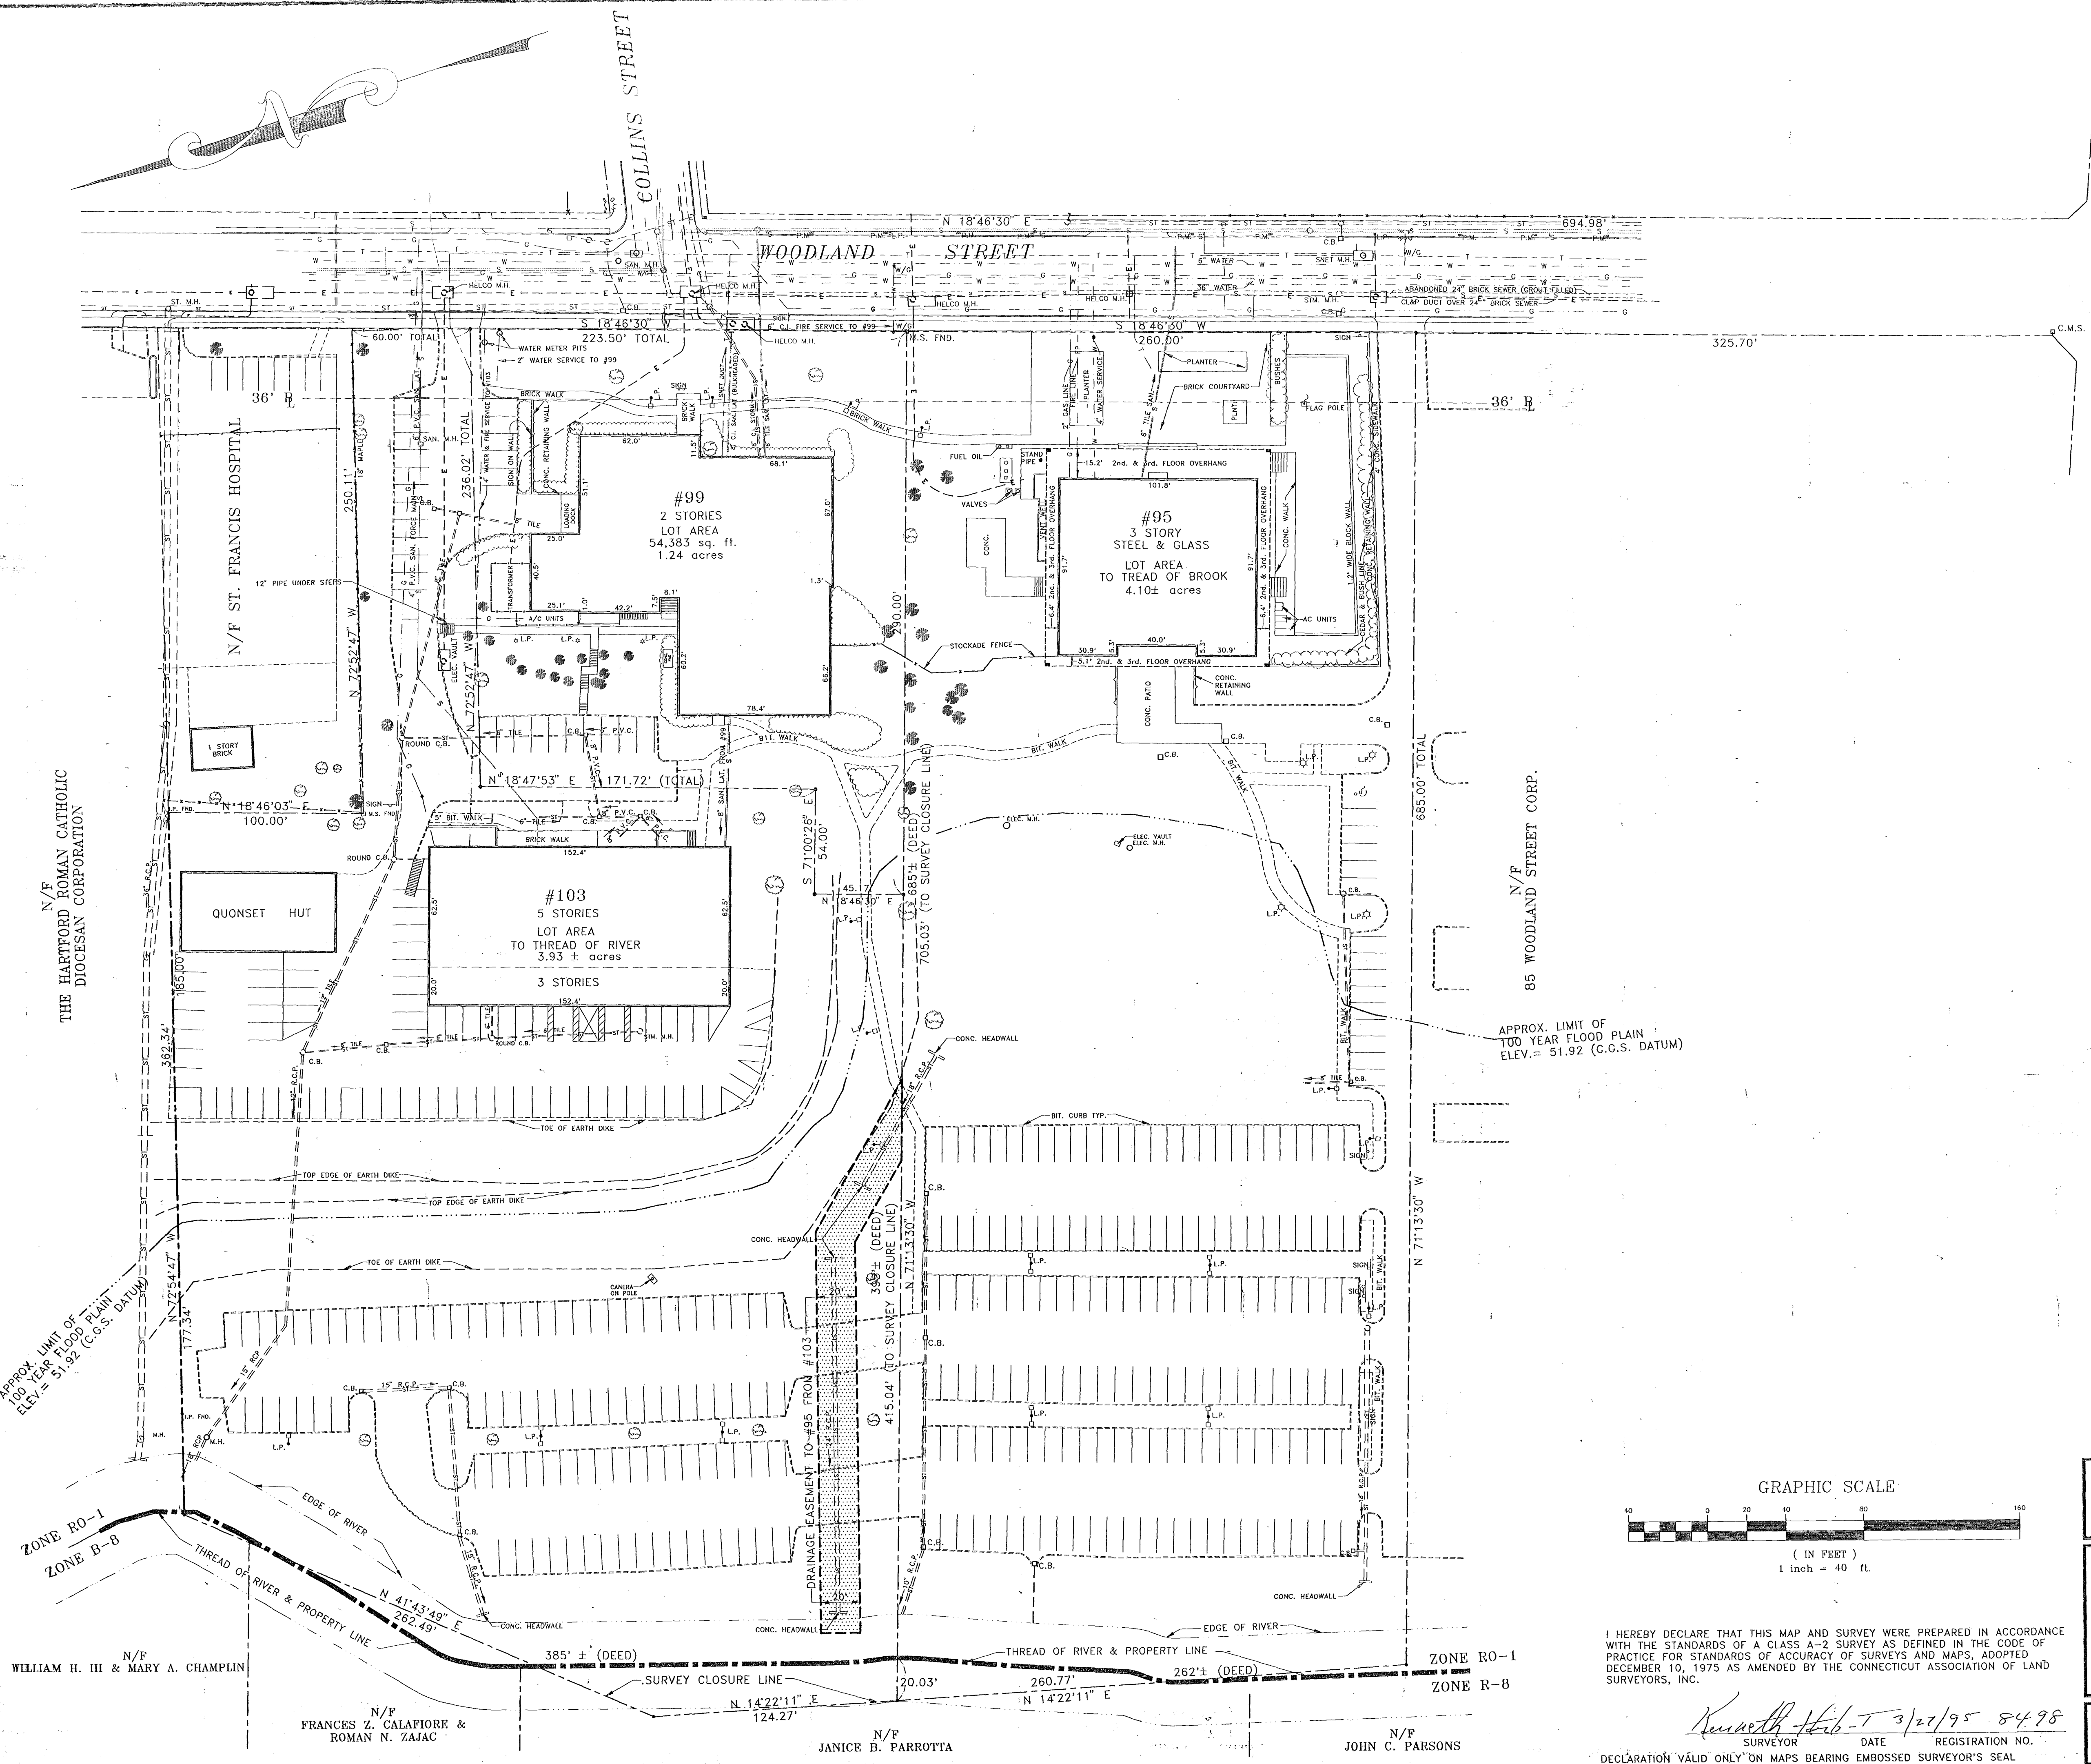


ASYLUM AVENUE

The portion of Woodland Street shown on this map is an established street of the City of Hartford.
O. Blint, Survey Supervisor

LEGEND	
	EASEMENT LINE
	PROPERTY LINE
	SANITARY SEWER LINE
	STORM SEWER LINE
	WATER LINE
	UNDERGROUND ELECTRIC LINE
	UNDERGROUND TELEPHONE LINE
	GAS LINE
	BIT CURB
	CONC. OR GRANITE CURB
	EDGE OF PAVEMENT

MAP REF.: "PROPERTY SURVEY PREPARED FOR ONE THOUSAND CORPORATION & VISITING NURSE AND HOME CARE, INCORPORATED OF #95, #99 & #103 WOODLAND STREET, HARTFORD, CONNECTICUT"
SCALE: 1" = 40', DATED: NOV. 04, 1993,
PREPARED BY: HALLISEY & HERBERT

THIS MAP PRODUCED BY ORIGINAL INK DRAWING ON POLY FILM OF LINEN
HALLISEY & HERBERT
22 - JUDAS ROAD
ROCKY HILL, CT 06067

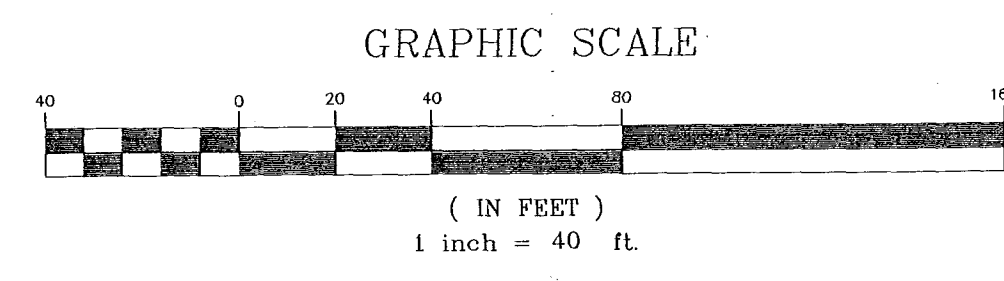

I HEREBY DECLARE THAT THIS MAP AND SURVEY WERE PREPARED IN ACCORDANCE WITH THE STANDARDS OF A CLASS A-2 SURVEY AS DEFINED IN THE CODE OF PRACTICE FOR STANDARDS OF ACCURACY OF SURVEYS AND MAPS, ADOPTED DECEMBER 10, 1975 AS AMENDED BY THE CONNECTICUT ASSOCIATION OF LAND SURVEYORS, INC.

Kenneth Hib-T 3/27/95 8498
SURVEYOR DATE REGISTRATION NO.

DECLARATION VALID ONLY ON MAPS BEARING EMBOSSED SURVEYOR'S SEAL

HALLISEY & HERBERT CIVIL ENGINEERS & LAND SURVEYORS 78 BEAVER ROAD, WETHERSFIELD, CONNECTICUT	DRAWN J.P.C. CHECKED K.H. DATE MAY 31, 1994 SCALE 1" = 40' SHEET 1 OF 1 JOB NO. 1344-95 AUTOCAD FILE: 1344-958.DWG
	DRAINAGE EASEMENT TO BE GRANTED TO #95 WOODLAND STREET FROM #103 WOODLAND STREET HARTFORD, CONNECTICUT