


OSWALD R. BLINT, ASSOC.
ORIGINAL INK DRAWING
ON MYLAR.

The portion of Nelson Street, shown on this map
is an established public street of the City
of Hartford.

O. Blint
Survey Supervisor

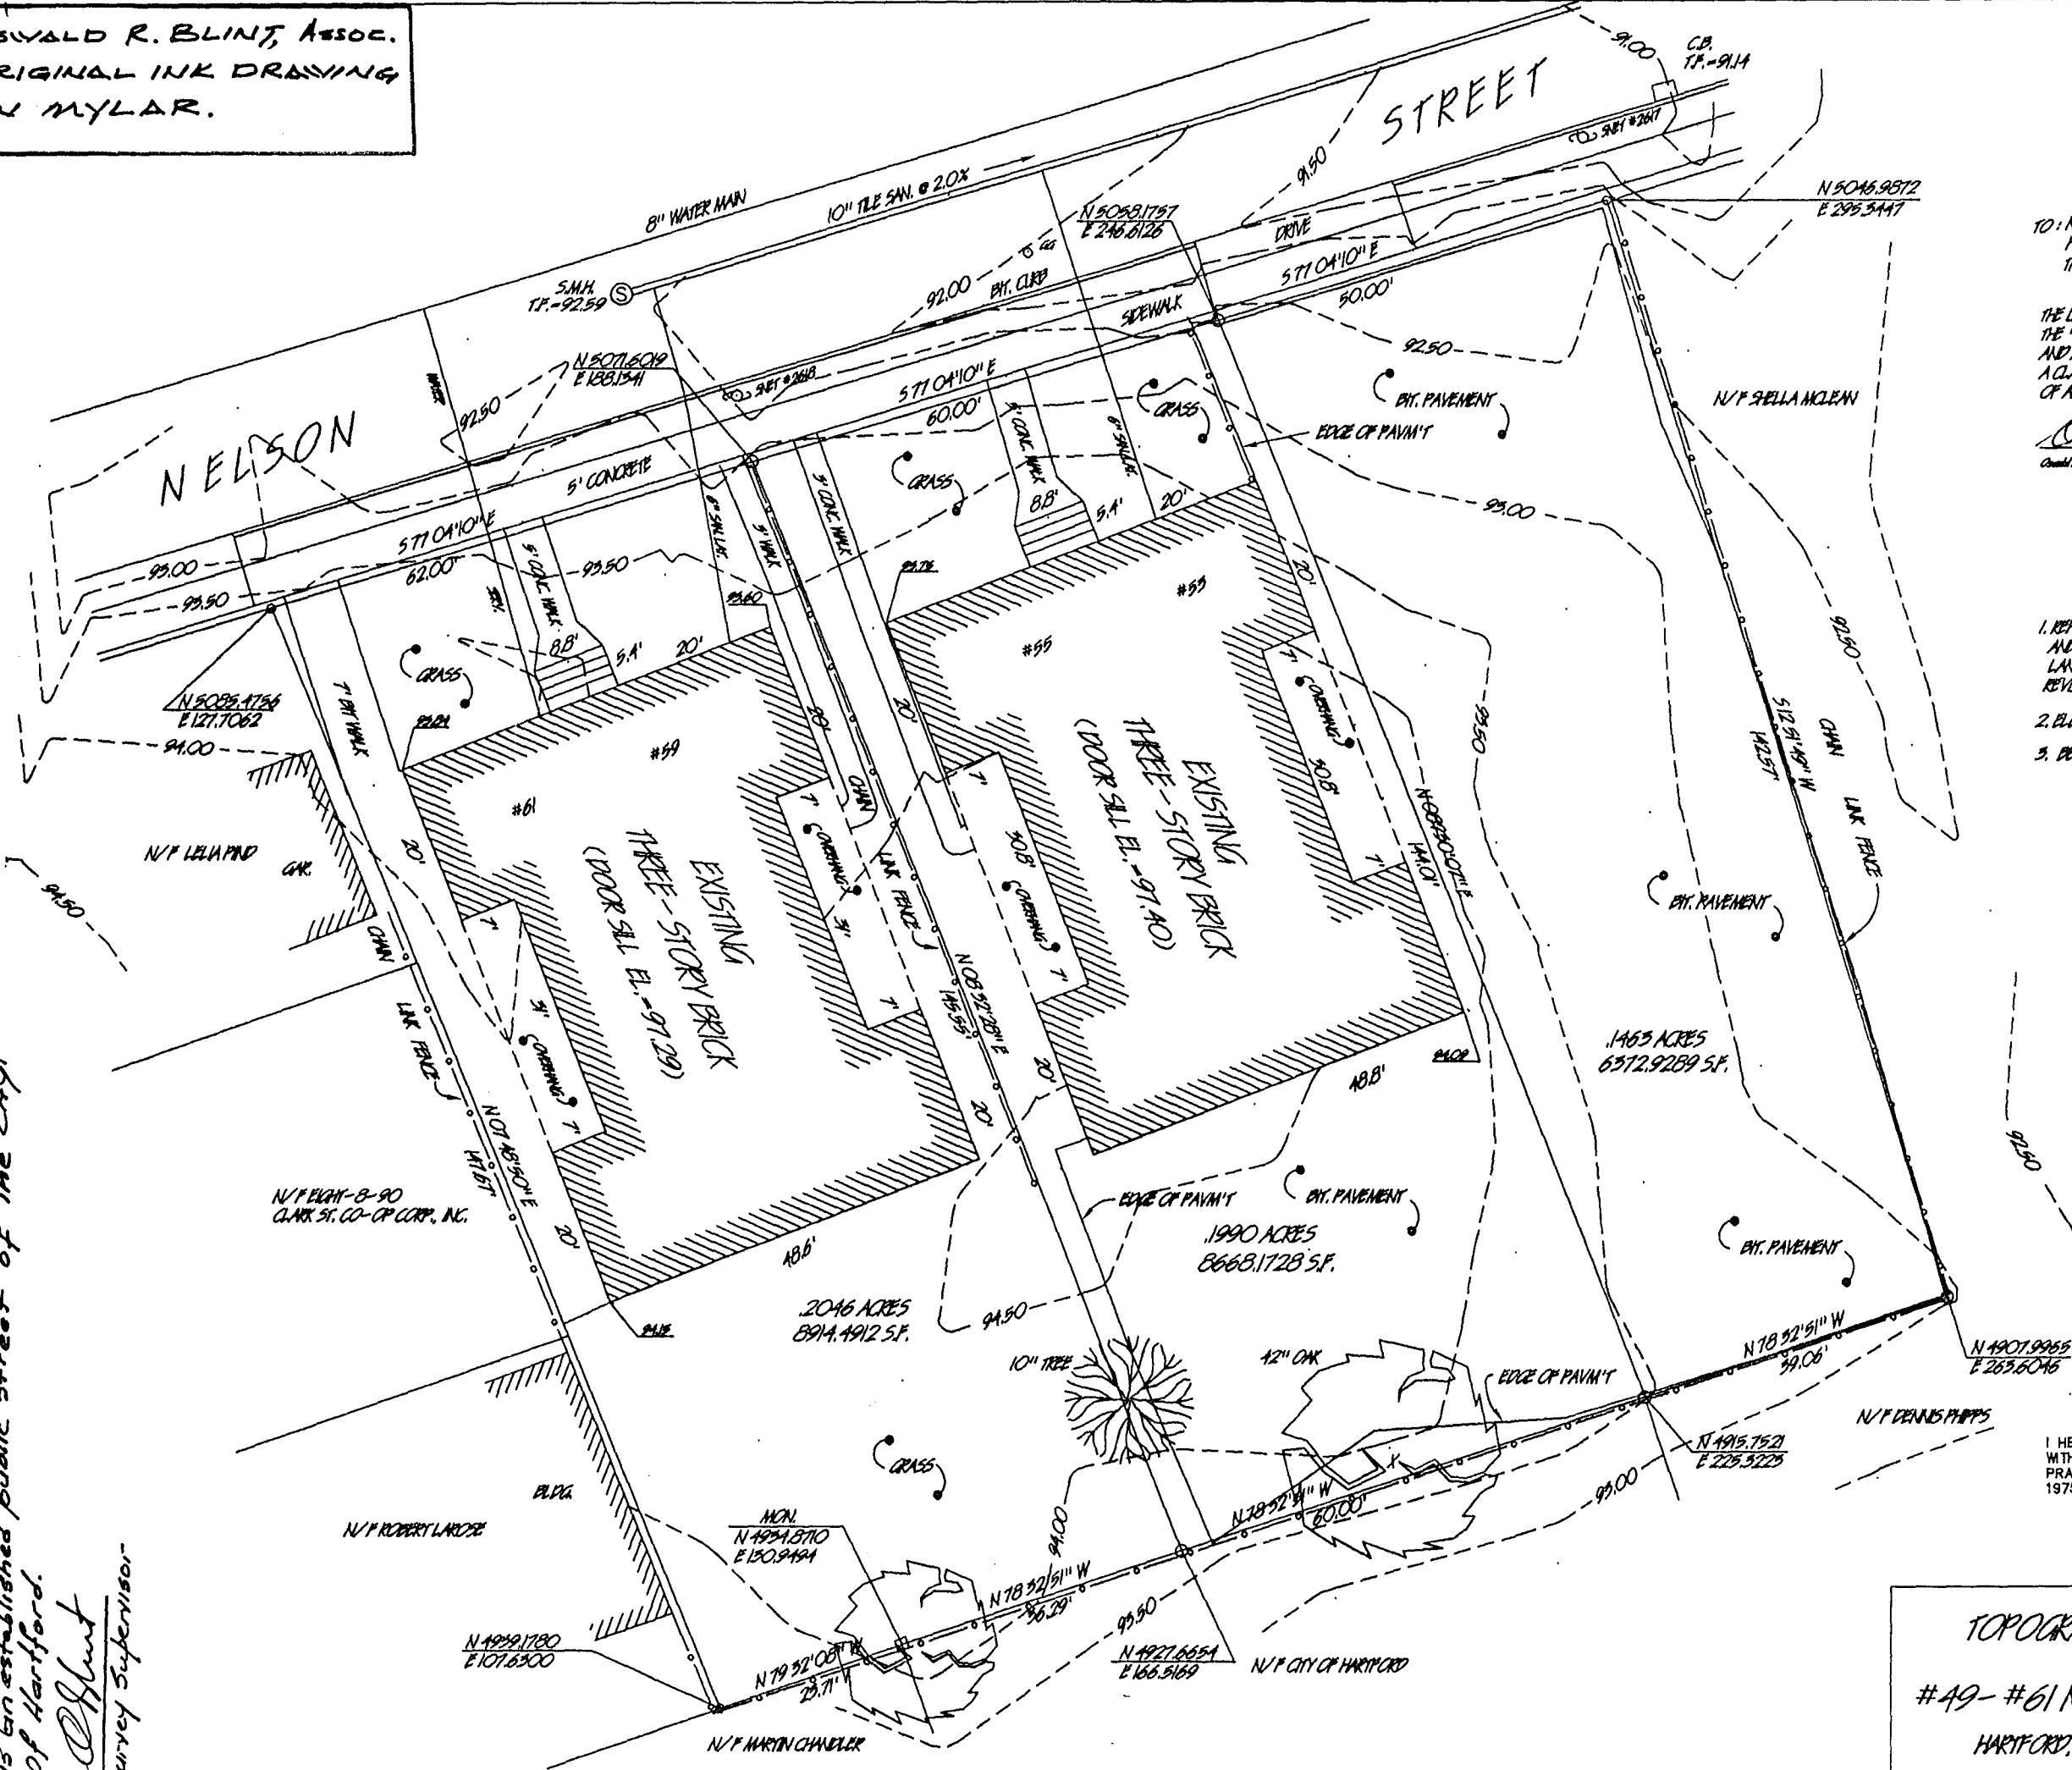

TO: NELSON STREET LIMITED PARTNERSHIP
FIRST AMERICAN TITLE INSURANCE COMPANY
THE CITY OF HARTFORD

THE UNDERSIGNED DOES HEREBY CERTIFY THAT THIS SURVEY WAS MADE IN ACCORDANCE WITH
THE "MINIMUM DETAIL REQUIREMENTS FOR ALTA/ACSM LAND TITLE SURVEYS" JOINTLY ESTABLISHED
AND ADOPTED BY ALTA AND ACSM IN 1986, AND MEETS THE ACCURACY REQUIREMENTS FOR
A CLASS A-2 SURVEY AS DEFINED THEREIN, AND ALSO IN ALL RESPECTS MEETS THE REQUIREMENTS
OF ALL APPLICABLE LAW.

O. Blint
Oswald R. Blint, survey reg. No. 12048

- MAP REFERENCES AND NOTES
1. REFERENCE IS HEREBY MADE TO A MAP ENTITLED "MESSRS. CASTONWAY, GOLDBERG,
AND KIRSTEAD, REVISED LOT PLAN HILL VIEW TRACT-HARTFORD, CT., THOMAS H. DESHARD
LANDSCAPE ARCHITECT SIMPLY, CONN., SCALE 1"=50', DRAWING NO. 6, FILE 140,
REVISED OCT. 20, 1920, DATE MAY 28, 1920."
 2. ELEVATIONS ARE BASED ON METROPOLITAN DISTRICT DATUM.
 3. BENCHMARK ELEVATION 91.93 PK. N.W. COR. ACTON/NELSON STREETS.

SYMBOLS AND ABBREVIATIONS			

I HEREBY CERTIFY THAT THIS MAP AND SURVEY WERE PREPARED IN ACCORDANCE WITH
THE STANDARDS OF A CLASS A2 SURVEY AS DEFINED IN THE CODE OF
PRACTICE FOR STANDARDS OF ACCURACY OF SURVEYS AND MAPS, ADOPTED DEC.
1975 BY THE CONNECTICUT ASSOCIATION OF LAND SURVEYORS, INC.

TOPOGRAPHIC PLAN
OF
#49- #61 NELSON STREET
HARTFORD, CONNECTICUT

REVISIONS

OSWALD R. BLINT
REGISTERED LAND SURVEYOR
HARTFORD, CONNECTICUT

SCALE: 1"=20' DATE JULY 28, 1995