

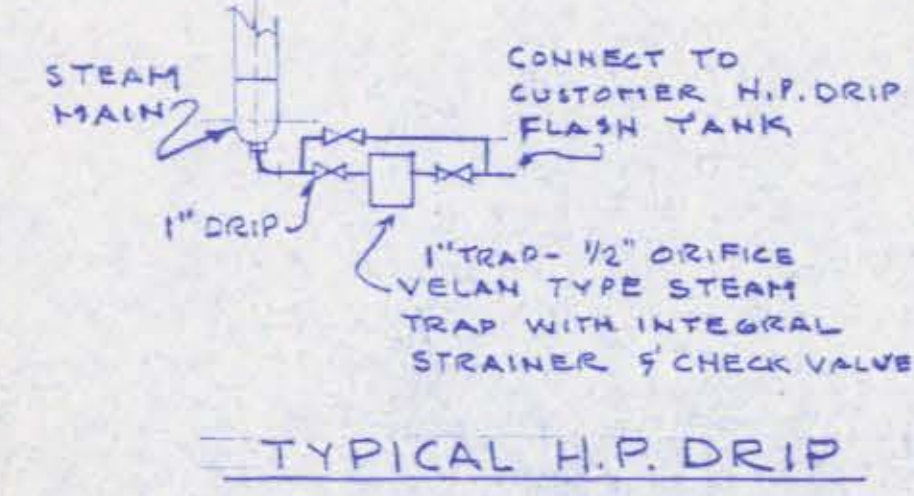
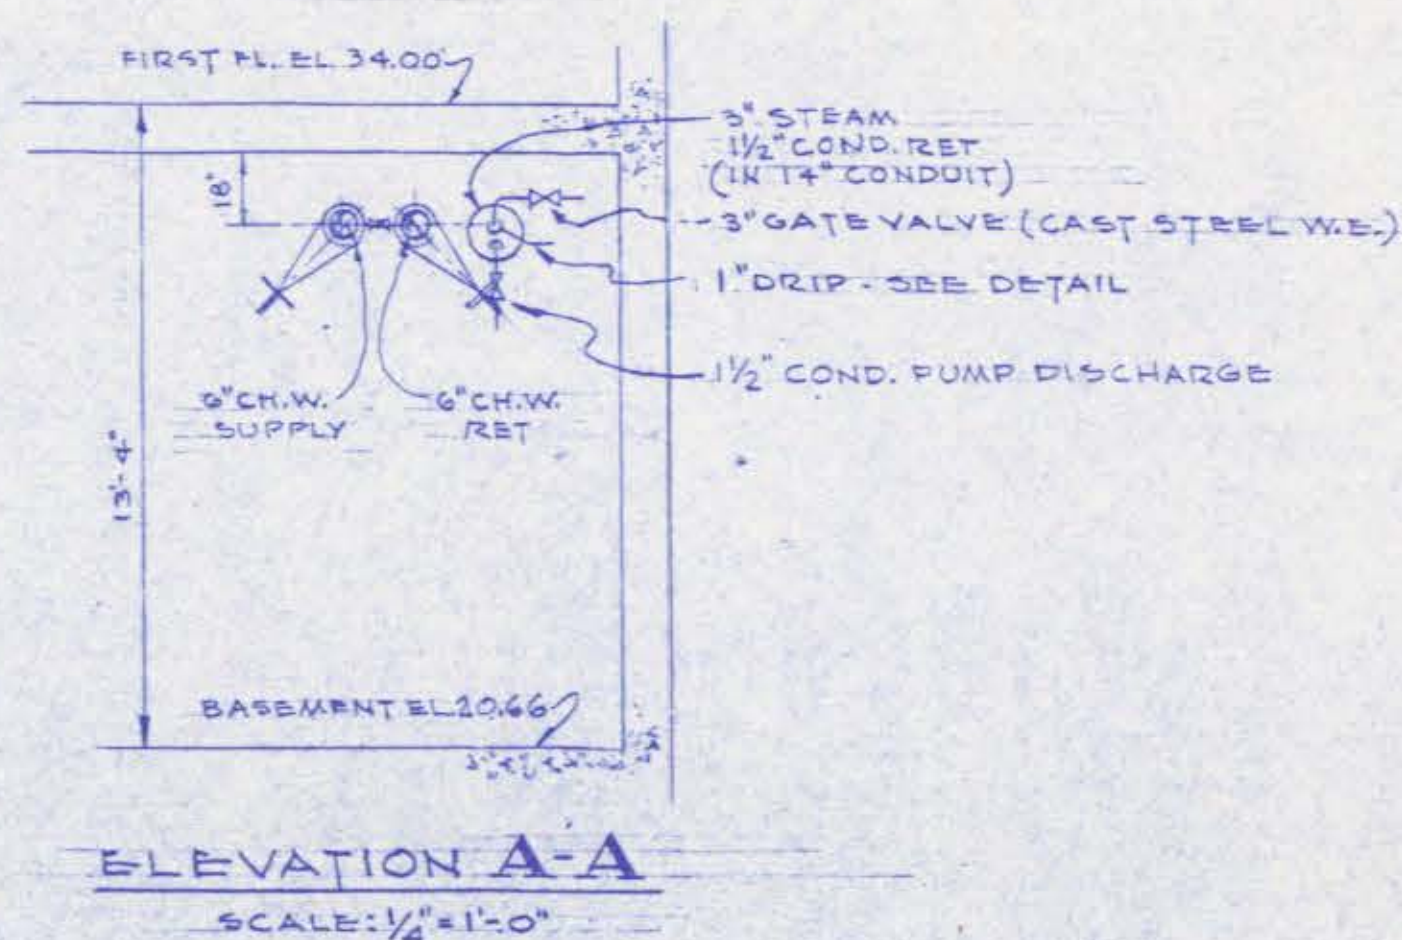
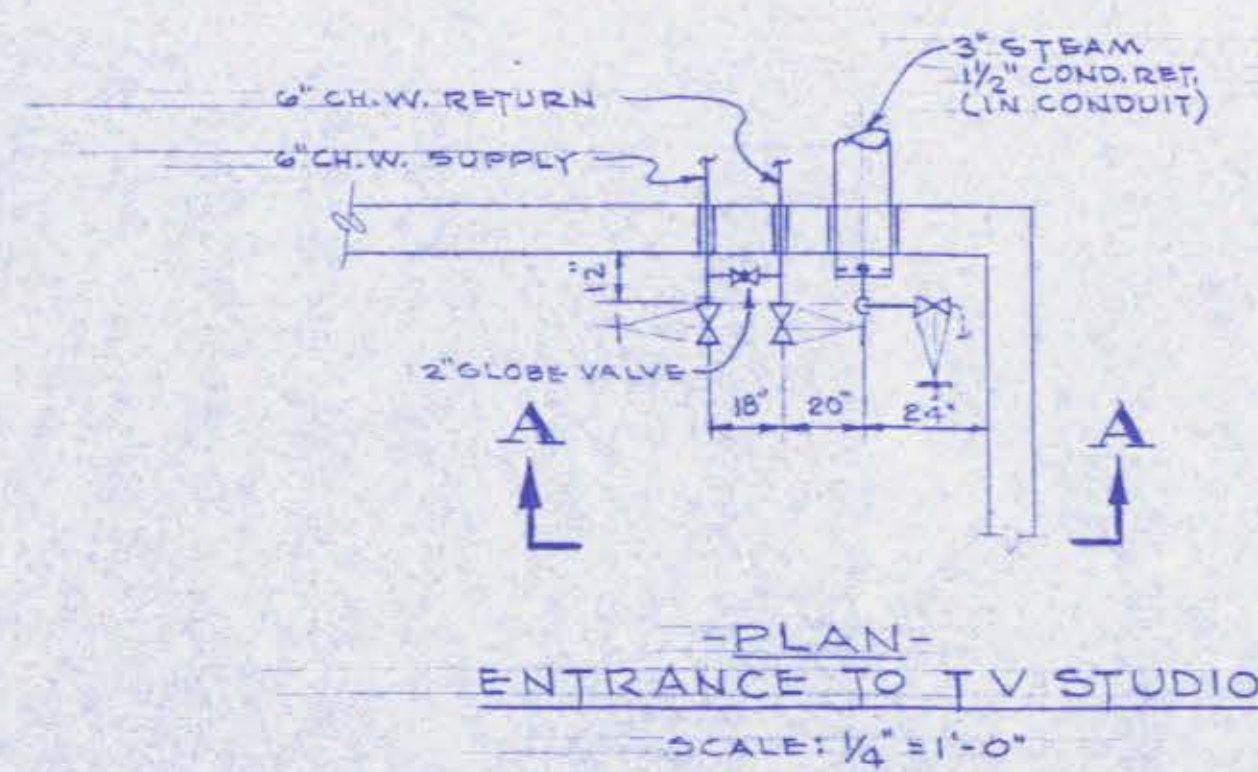


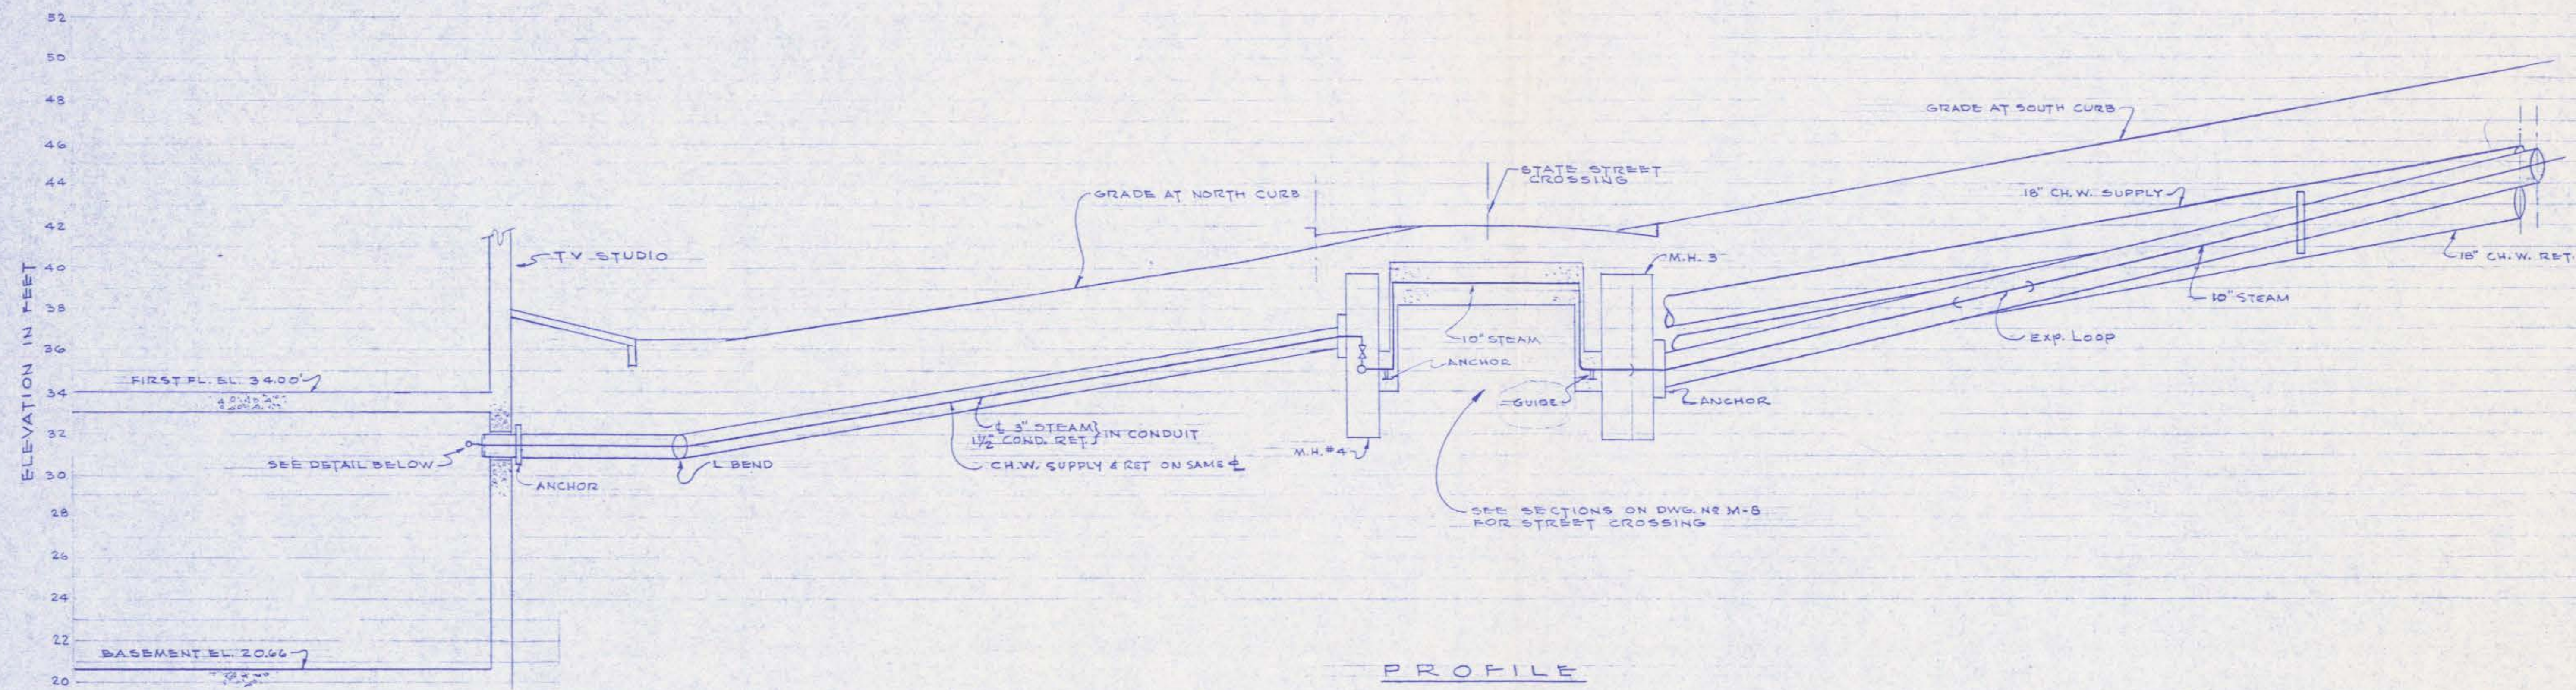

MATERIALS	QUANTITY
1) 5'x3.5'x4" M.H.	1
2) TRENCH	178'
3) SCH 40 4" STEEL CONDUIT	118'
4) SCH 40 4" PVC CONDUIT	—
5) STEEL COUPLERS	5
6) PVC COUPLERS	—
7) 4" 10' 5" TRANSITION	—

DATE	REVISIONS	APPD.
12-3-60	1) MOVED M.H. AND RET. 4'-0" NORTH ON STATE STREET	WDR
10-31-60	2) MOVED M.H. 3 - 4'-0" NORTH	WDR
10-19-60	3) DELETED EXP. LOOP 4" AT M.H. 3	WDR
	4) CHANGED ANCHOR TO GUIDE	
	5) REVISIONS TO BIDDING COPY	
	6) RELOCATED SERVICE TO TV	
	7) 8'-0" - ADDED VALVES	

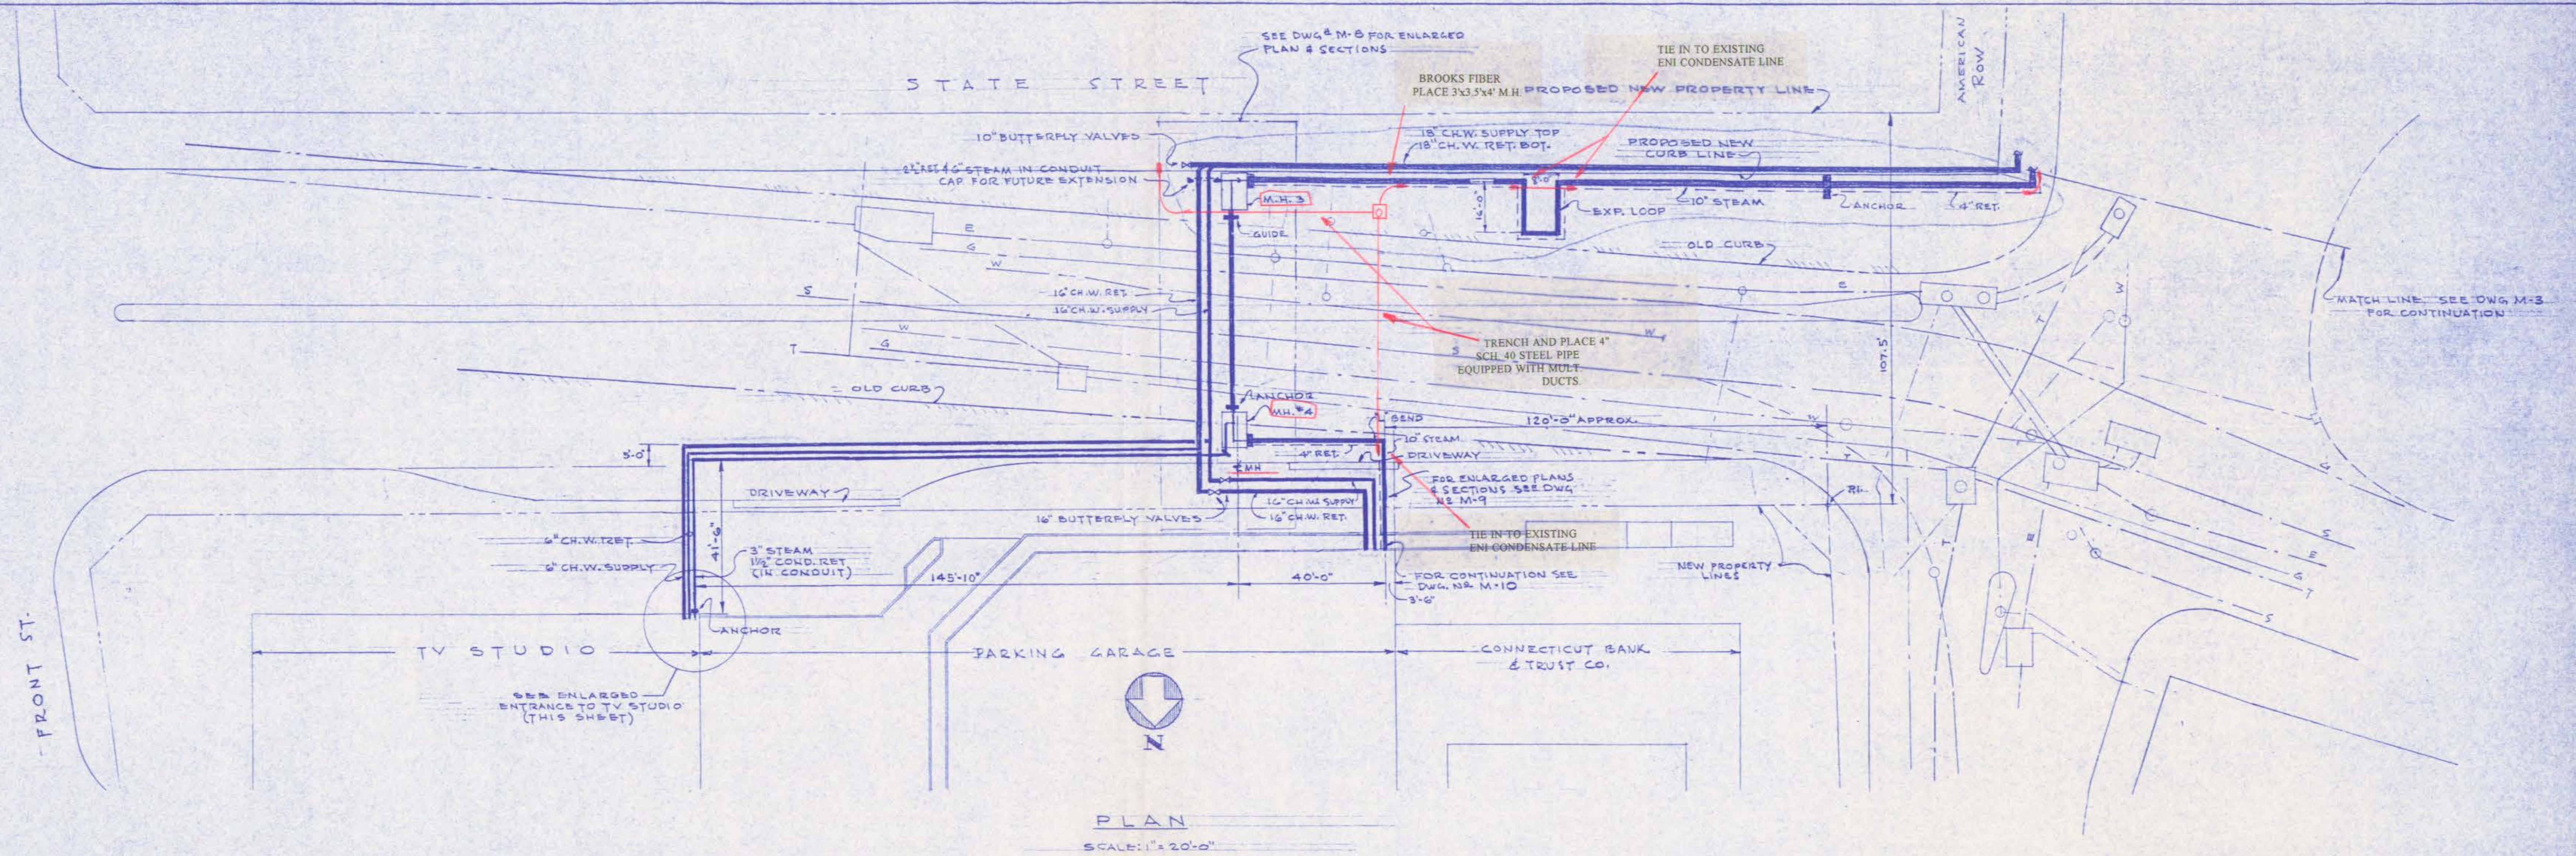

THE HARTFORD GAS COMPANY 233 PEARL STREET, HARTFORD 4, CONNECTICUT	
SEELYE STEVENSON VALUE & KNECHT CONSULTING ENGINEERS 101 PARK AVENUE, NEW YORK 17, N.Y.	DRAWN BY WDR CHECKED BY WDR APPROVED BY C.D. ARCHITECT 95 WOODLAND STREET HARTFORD 5, CONNECTICUT
CENTRAL HEATING AND REFRIGERATION PLANT UNDERGROUND PIPING SHEET TWO	
SCALE NOTED	DATE 10-19-60
DWG. NO. M-4	

MH3 & 4