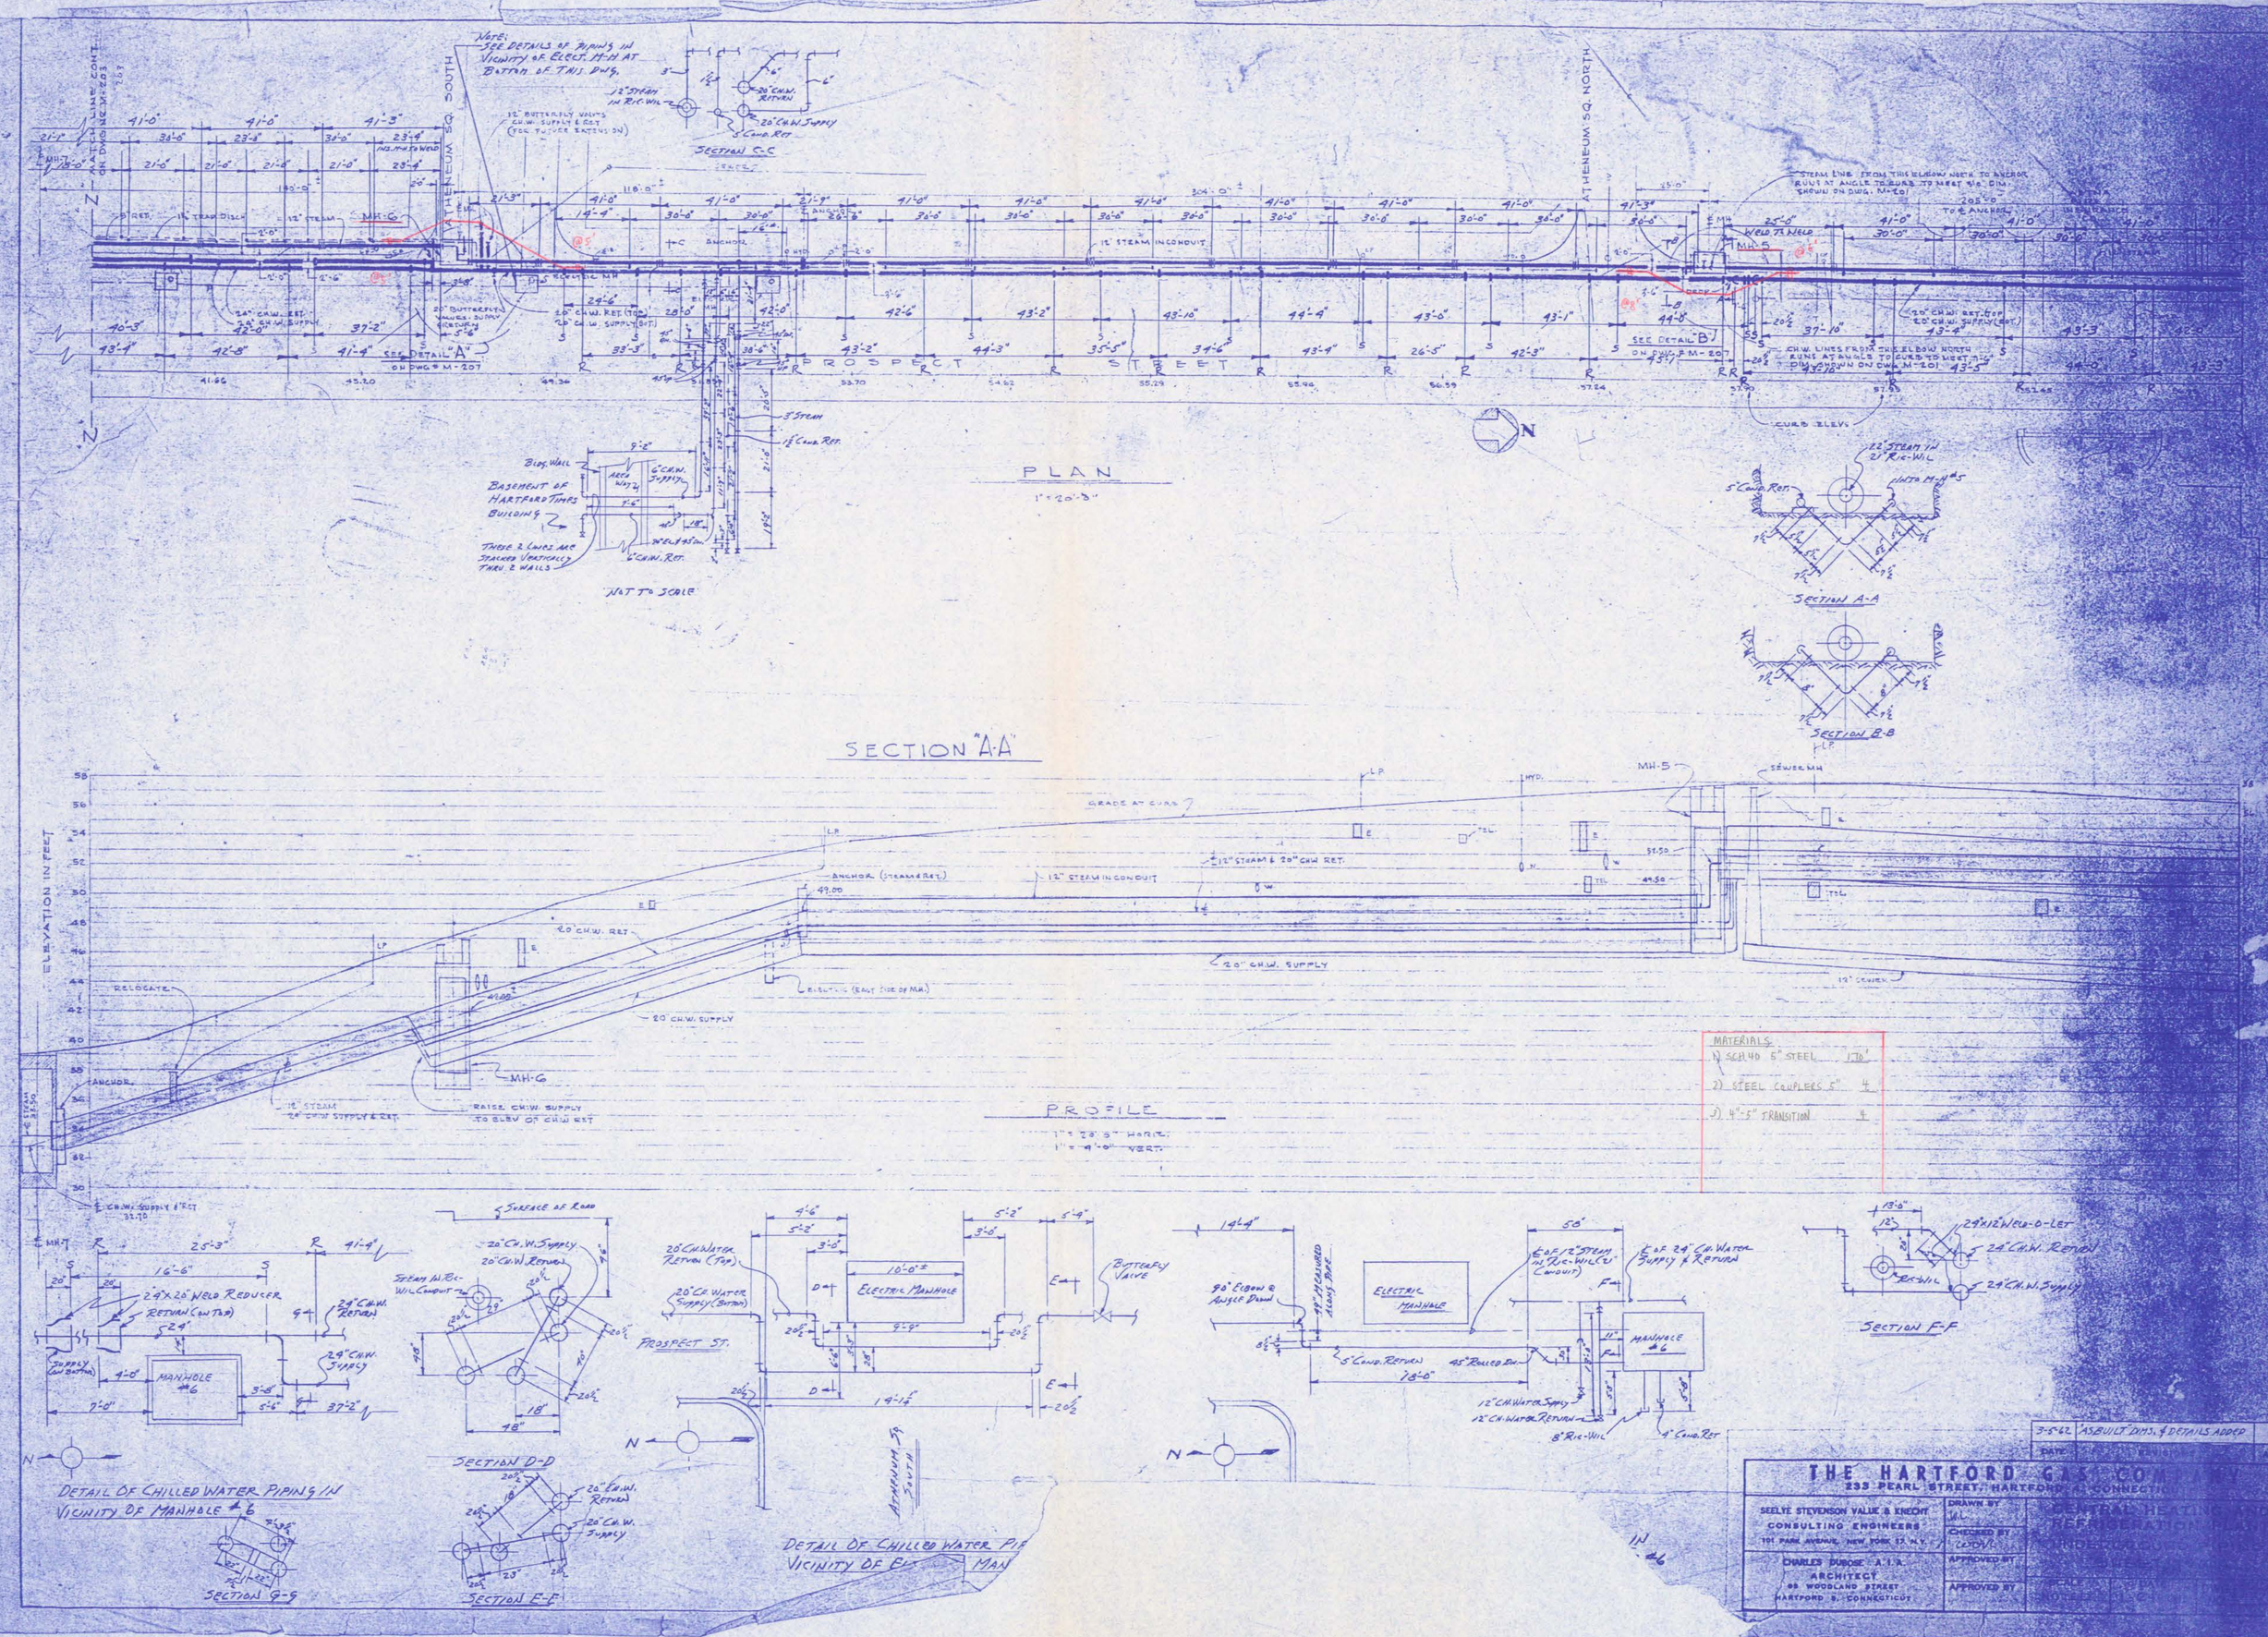
PLAN
1" = 20'-0"
SECTION "A-A"
PROFILE
1" = 20'-0" HORIZ.
1" = 4'-0" VERT.
PROSPECT STREET
ATHENEUM SQ. SOUTH
ATHENEUM SQ. NORTH
SECTION C-C
SECTION A-A
SECTION B-B
SECTION D-D
SECTION E-E
SECTION F-F
SECTION G-G
DETAIL OF CHILLED WATER PIPING IN VICINITY OF MANHOLE #6
DETAIL OF CHILLED WATER PIPING IN VICINITY OF ELEC. MAN. #6
NOTE: SEE DETAILS OF PIPING IN VICINITY OF ELECT. M-H AT BOTTOM OF THIS DWG.
NOT TO SCALE
MATERIALS
1) SCH 40 5" STEEL 170'
2) STEEL COUPLERS 5" 4
3) 4"-5" TRANSITION 4
THE HARTFORD GAS COMPANY
233 PEARL STREET, HARTFORD 3, CONNECTICUT
SEELYE STEVENSON VALUE & KNECHT
CONSULTING ENGINEERS
101 PARK AVENUE, NEW YORK 17, N.Y.
CHARLES DUBOIS A.I.A.
ARCHITECT
95 WOODLAND STREET
HARTFORD 5, CONNECTICUT
DRAWN BY
CHECKED BY
APPROVED BY
APPROVED BY
3-5-62 "ASBUILT" DIMS. & DETAILS ADDED
DATE REVISION
CENTRAL HEATING AND REFRIGERATION PLANT
UNDERGROUND
MH 5 & 6