


TRENCH AND PLACE 4"
SCH. 40 STEEL PIPE
EQUIPPED WITH MULT.
DUCTS

SEE DWG. U30-29


BROOKS FIBER
PLACE 3'x3.5'x4' M.H.

NOTES:


1. SEE GENERAL NOTES DWG. M-601.
2. FOR EXPANSION JOINT SCHEDULE
SEE DWG. M-601.

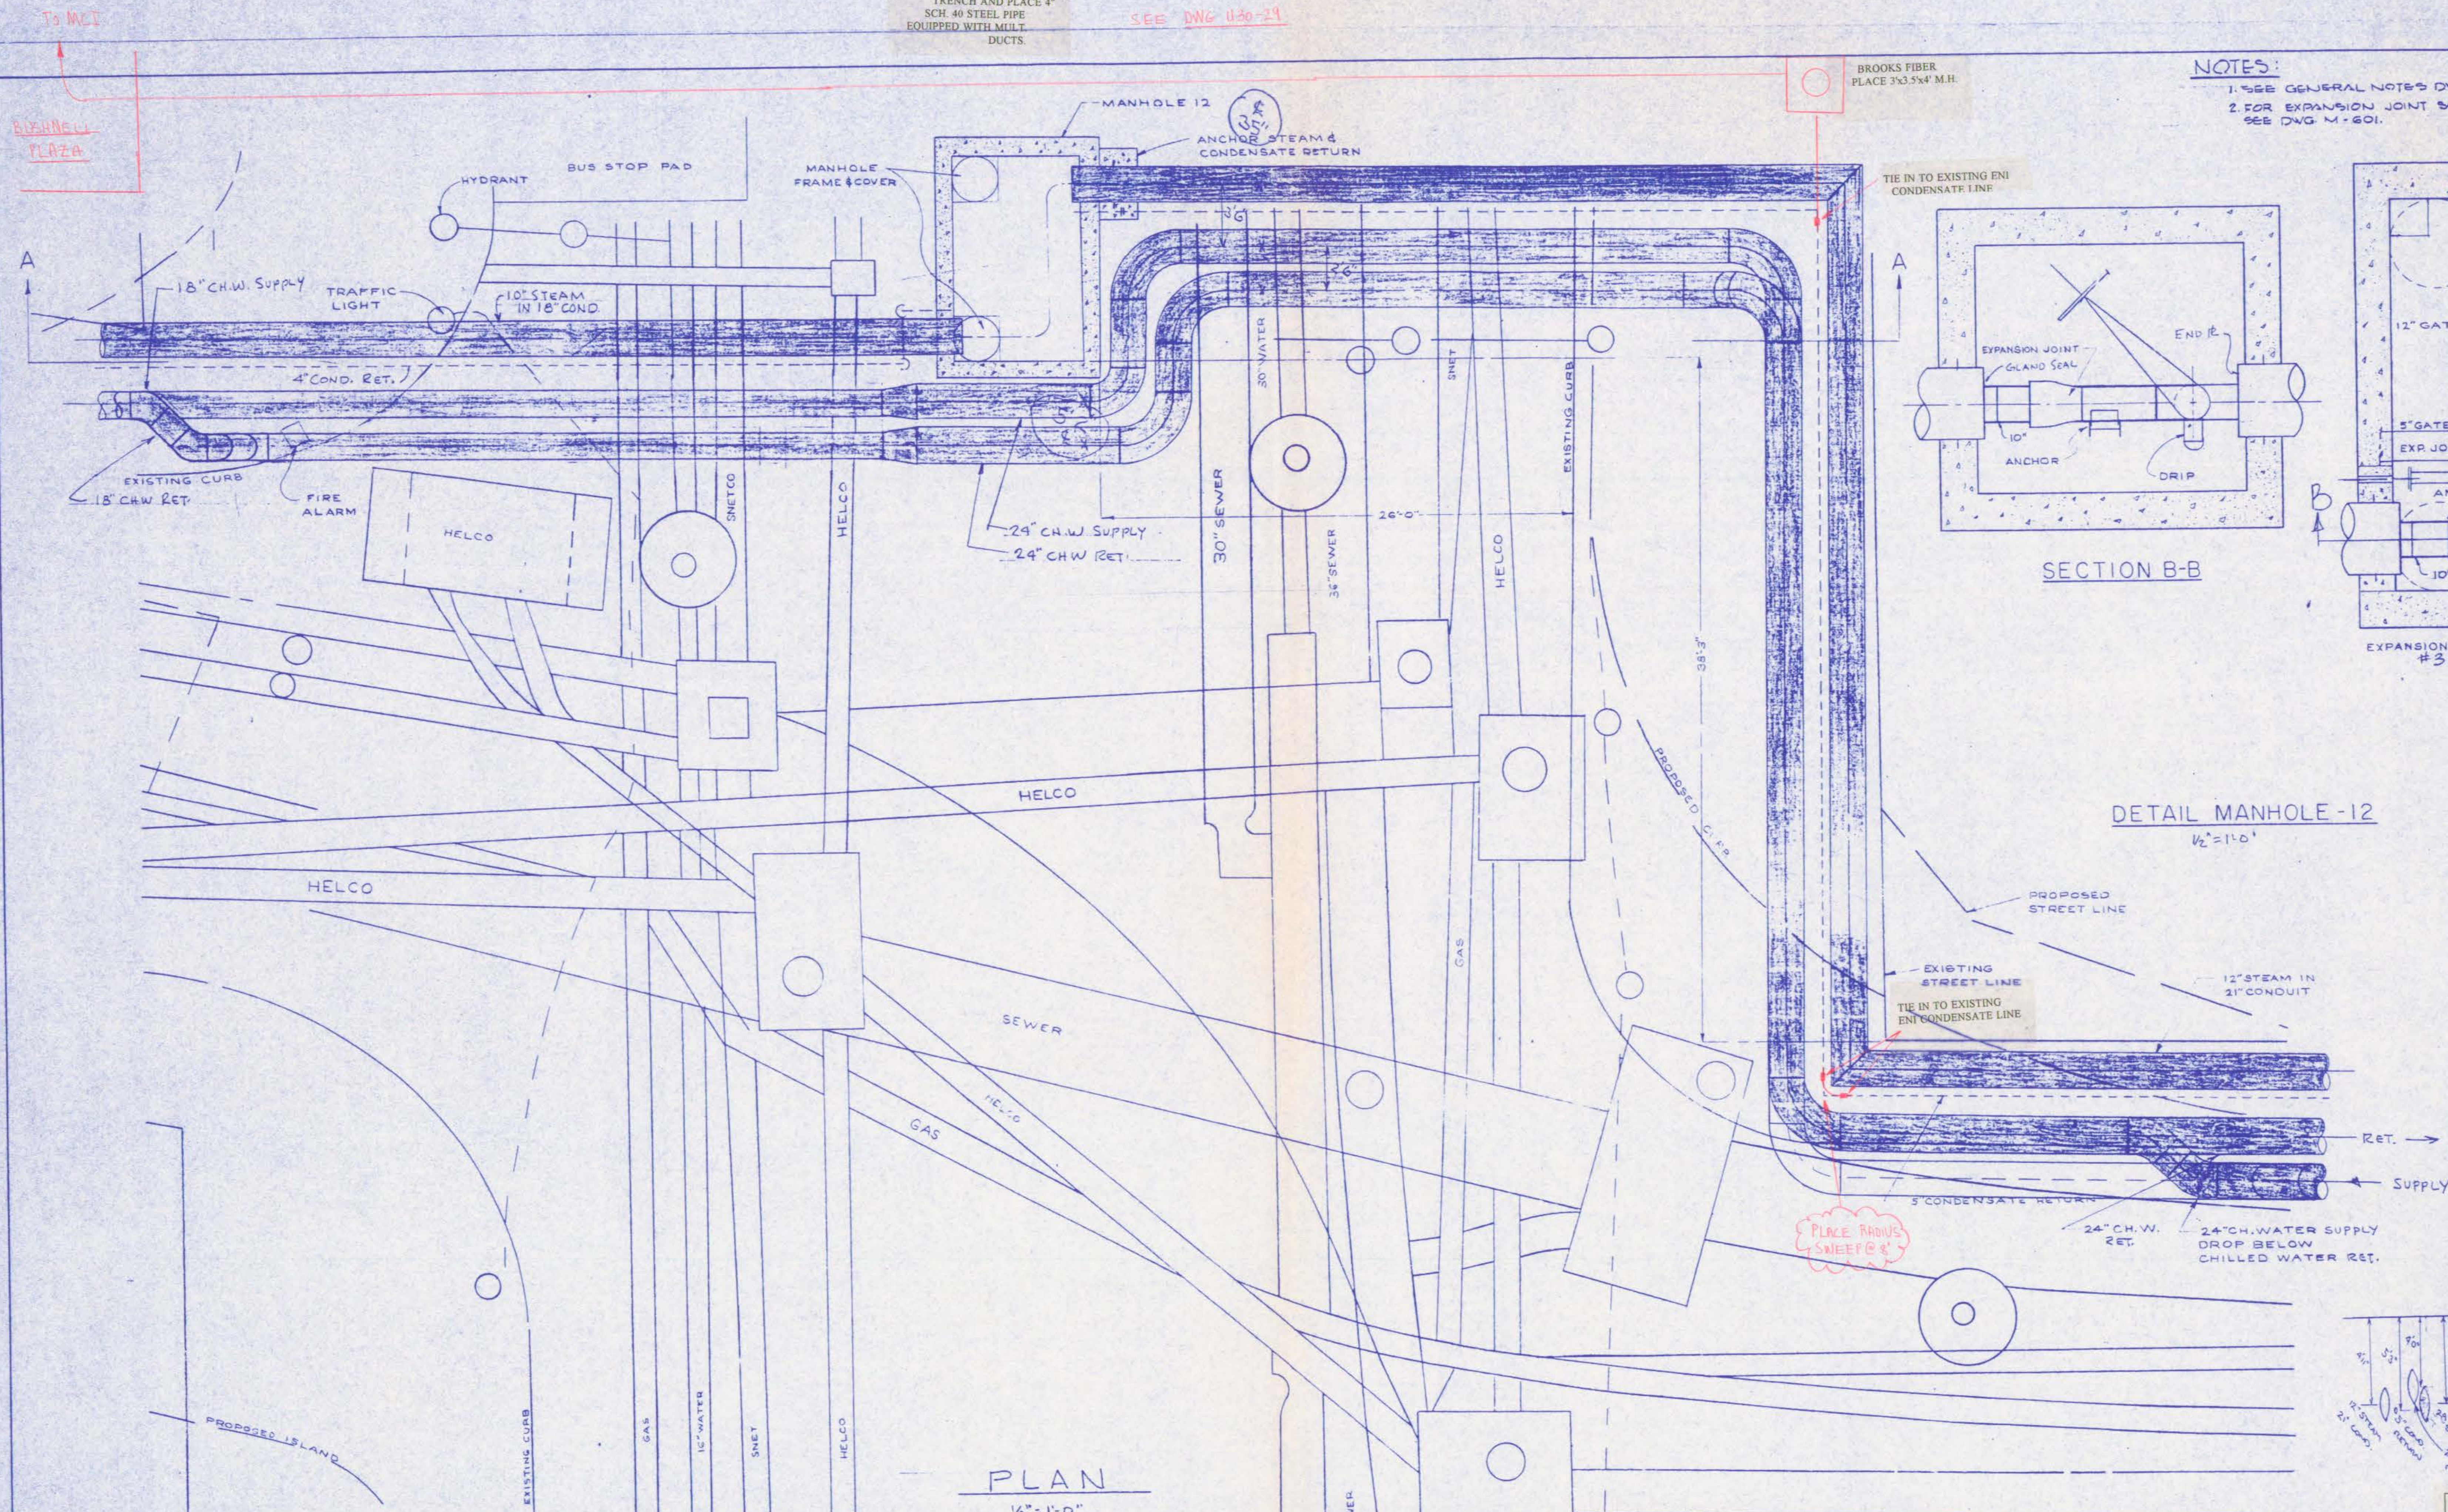

PLAN
1/4" = 1'-0"

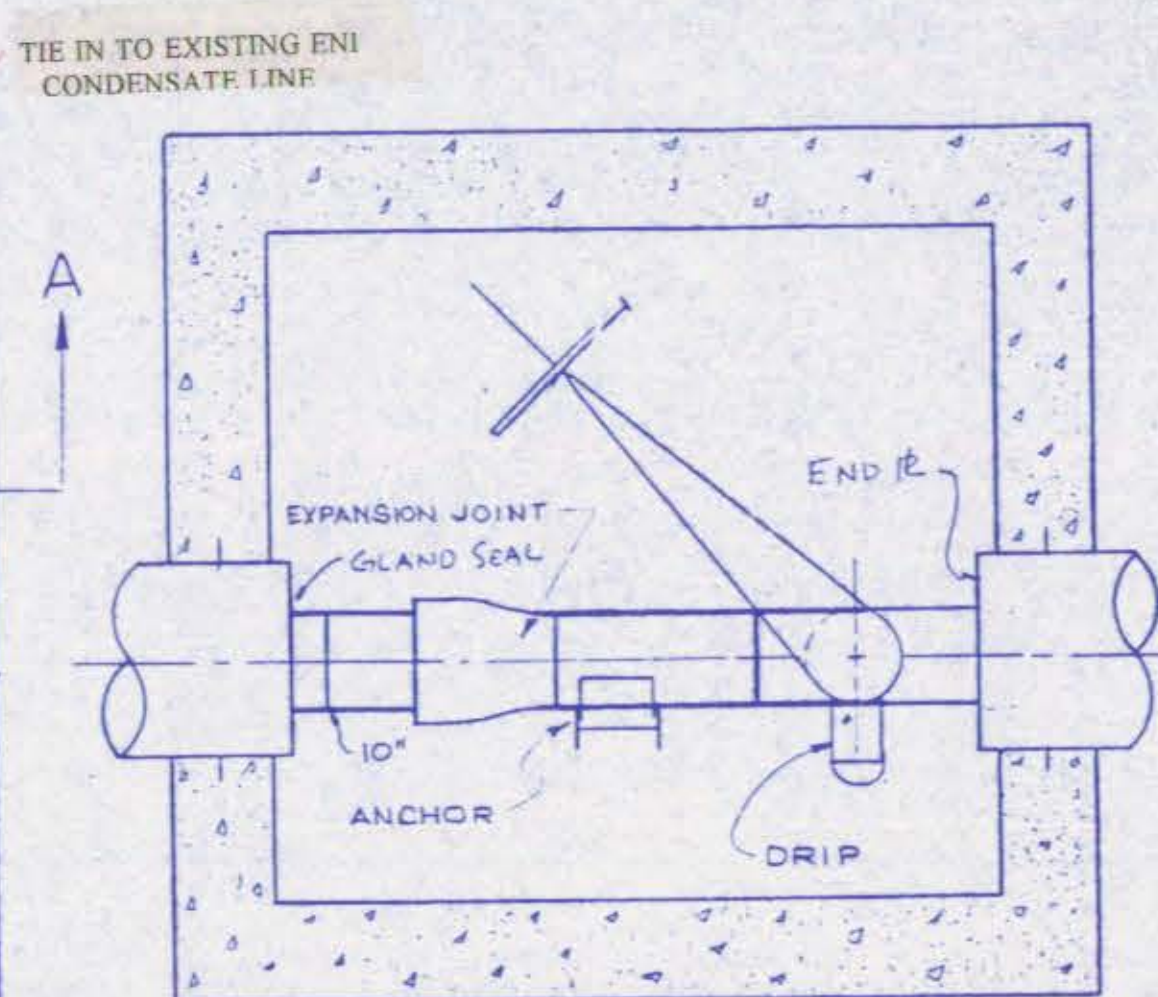


SECTION B-B

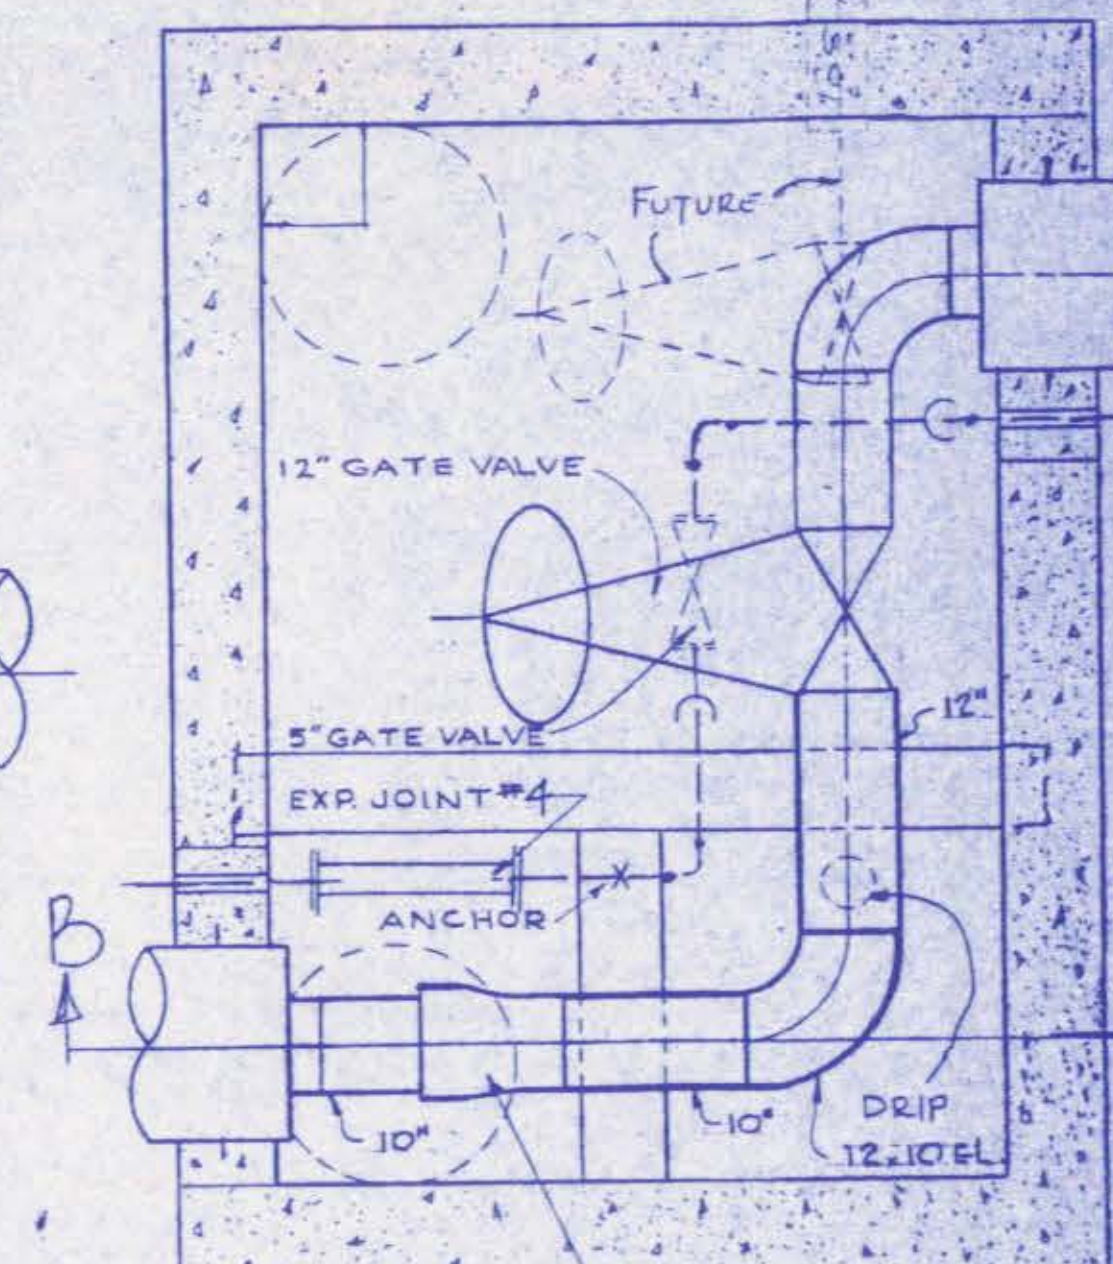

PLAN

DETAIL MANHOLE -12
1/2" = 1'-0"

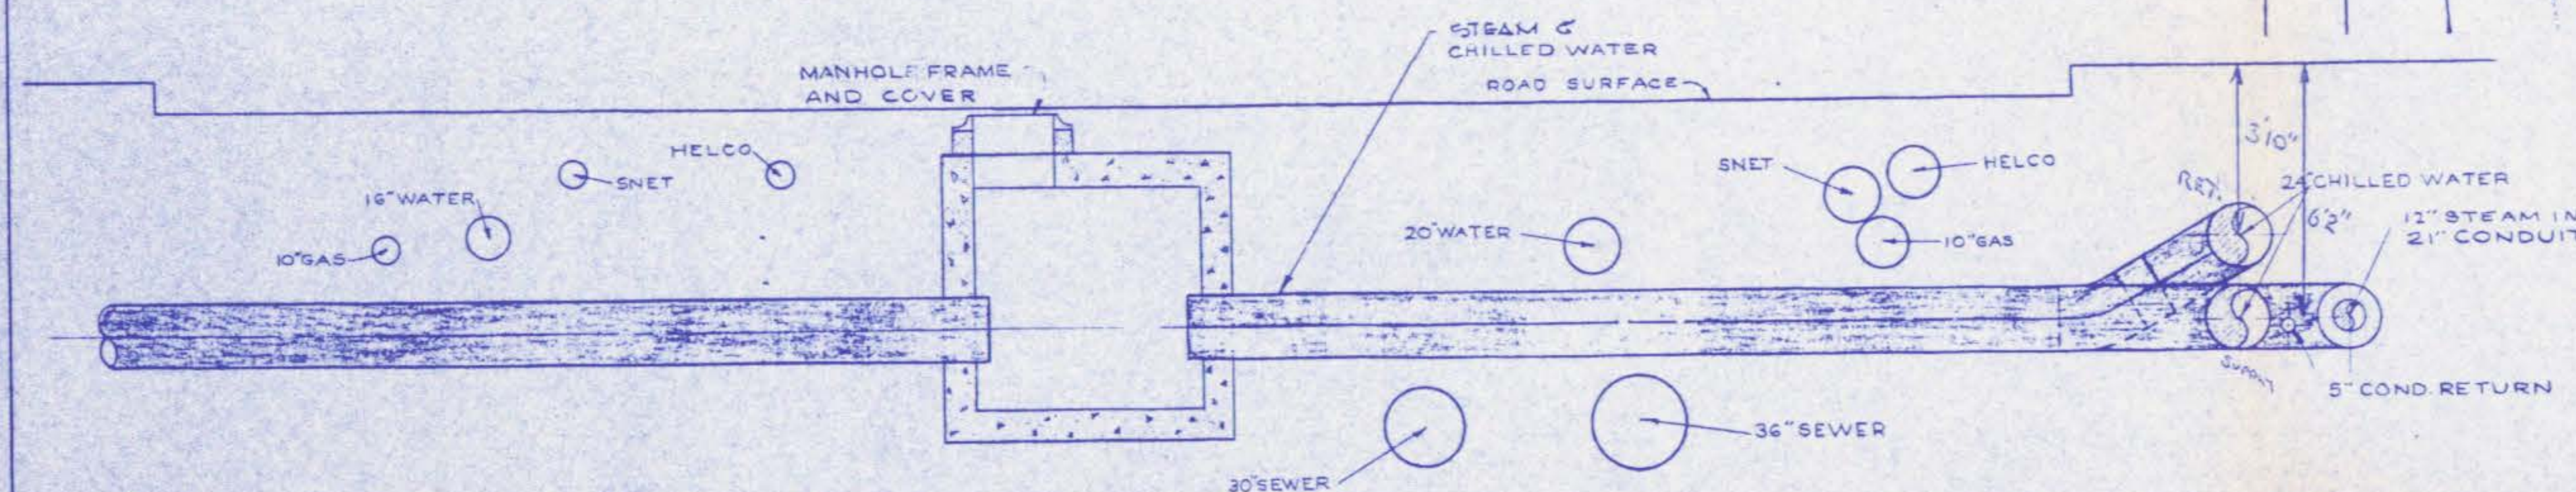

SECTION A-A
1/4" = 1'-0"

MATERIALS	QUANTITY
1) 3'x3.5'x4' M.H.	1
2) TRENCH	120'
3) SCH. 40 4" STEEL CONDUIT	110'
4) SCH. 40 4" PVC CONDUIT	—
5) STEEL COUPLERS	3
6) PVC COUPLERS	—
7) 4" TO 5" TRANSITION	1

THE HARTFORD STEAM COMPANY 233 PEARL STREET, HARTFORD 4, CONNECTICUT			
SEELYE STEVENSON VALUE & KNECHT, INC. CONSULTING ENGINEERS 99 PARK AVENUE, NEW YORK 16, N.Y.	DRAWN BY A.J.G. CHECKED BY W.L. APPROVED BY W.L.	DATE 4-4-66	REVISIONS APPROVED
CHARLES DUBOSE A.I.A. ARCHITECT 85 WOODLAND STREET HARTFORD 3, CONNECTICUT	DATE 4-4-66	DWG. NO. M-606	