
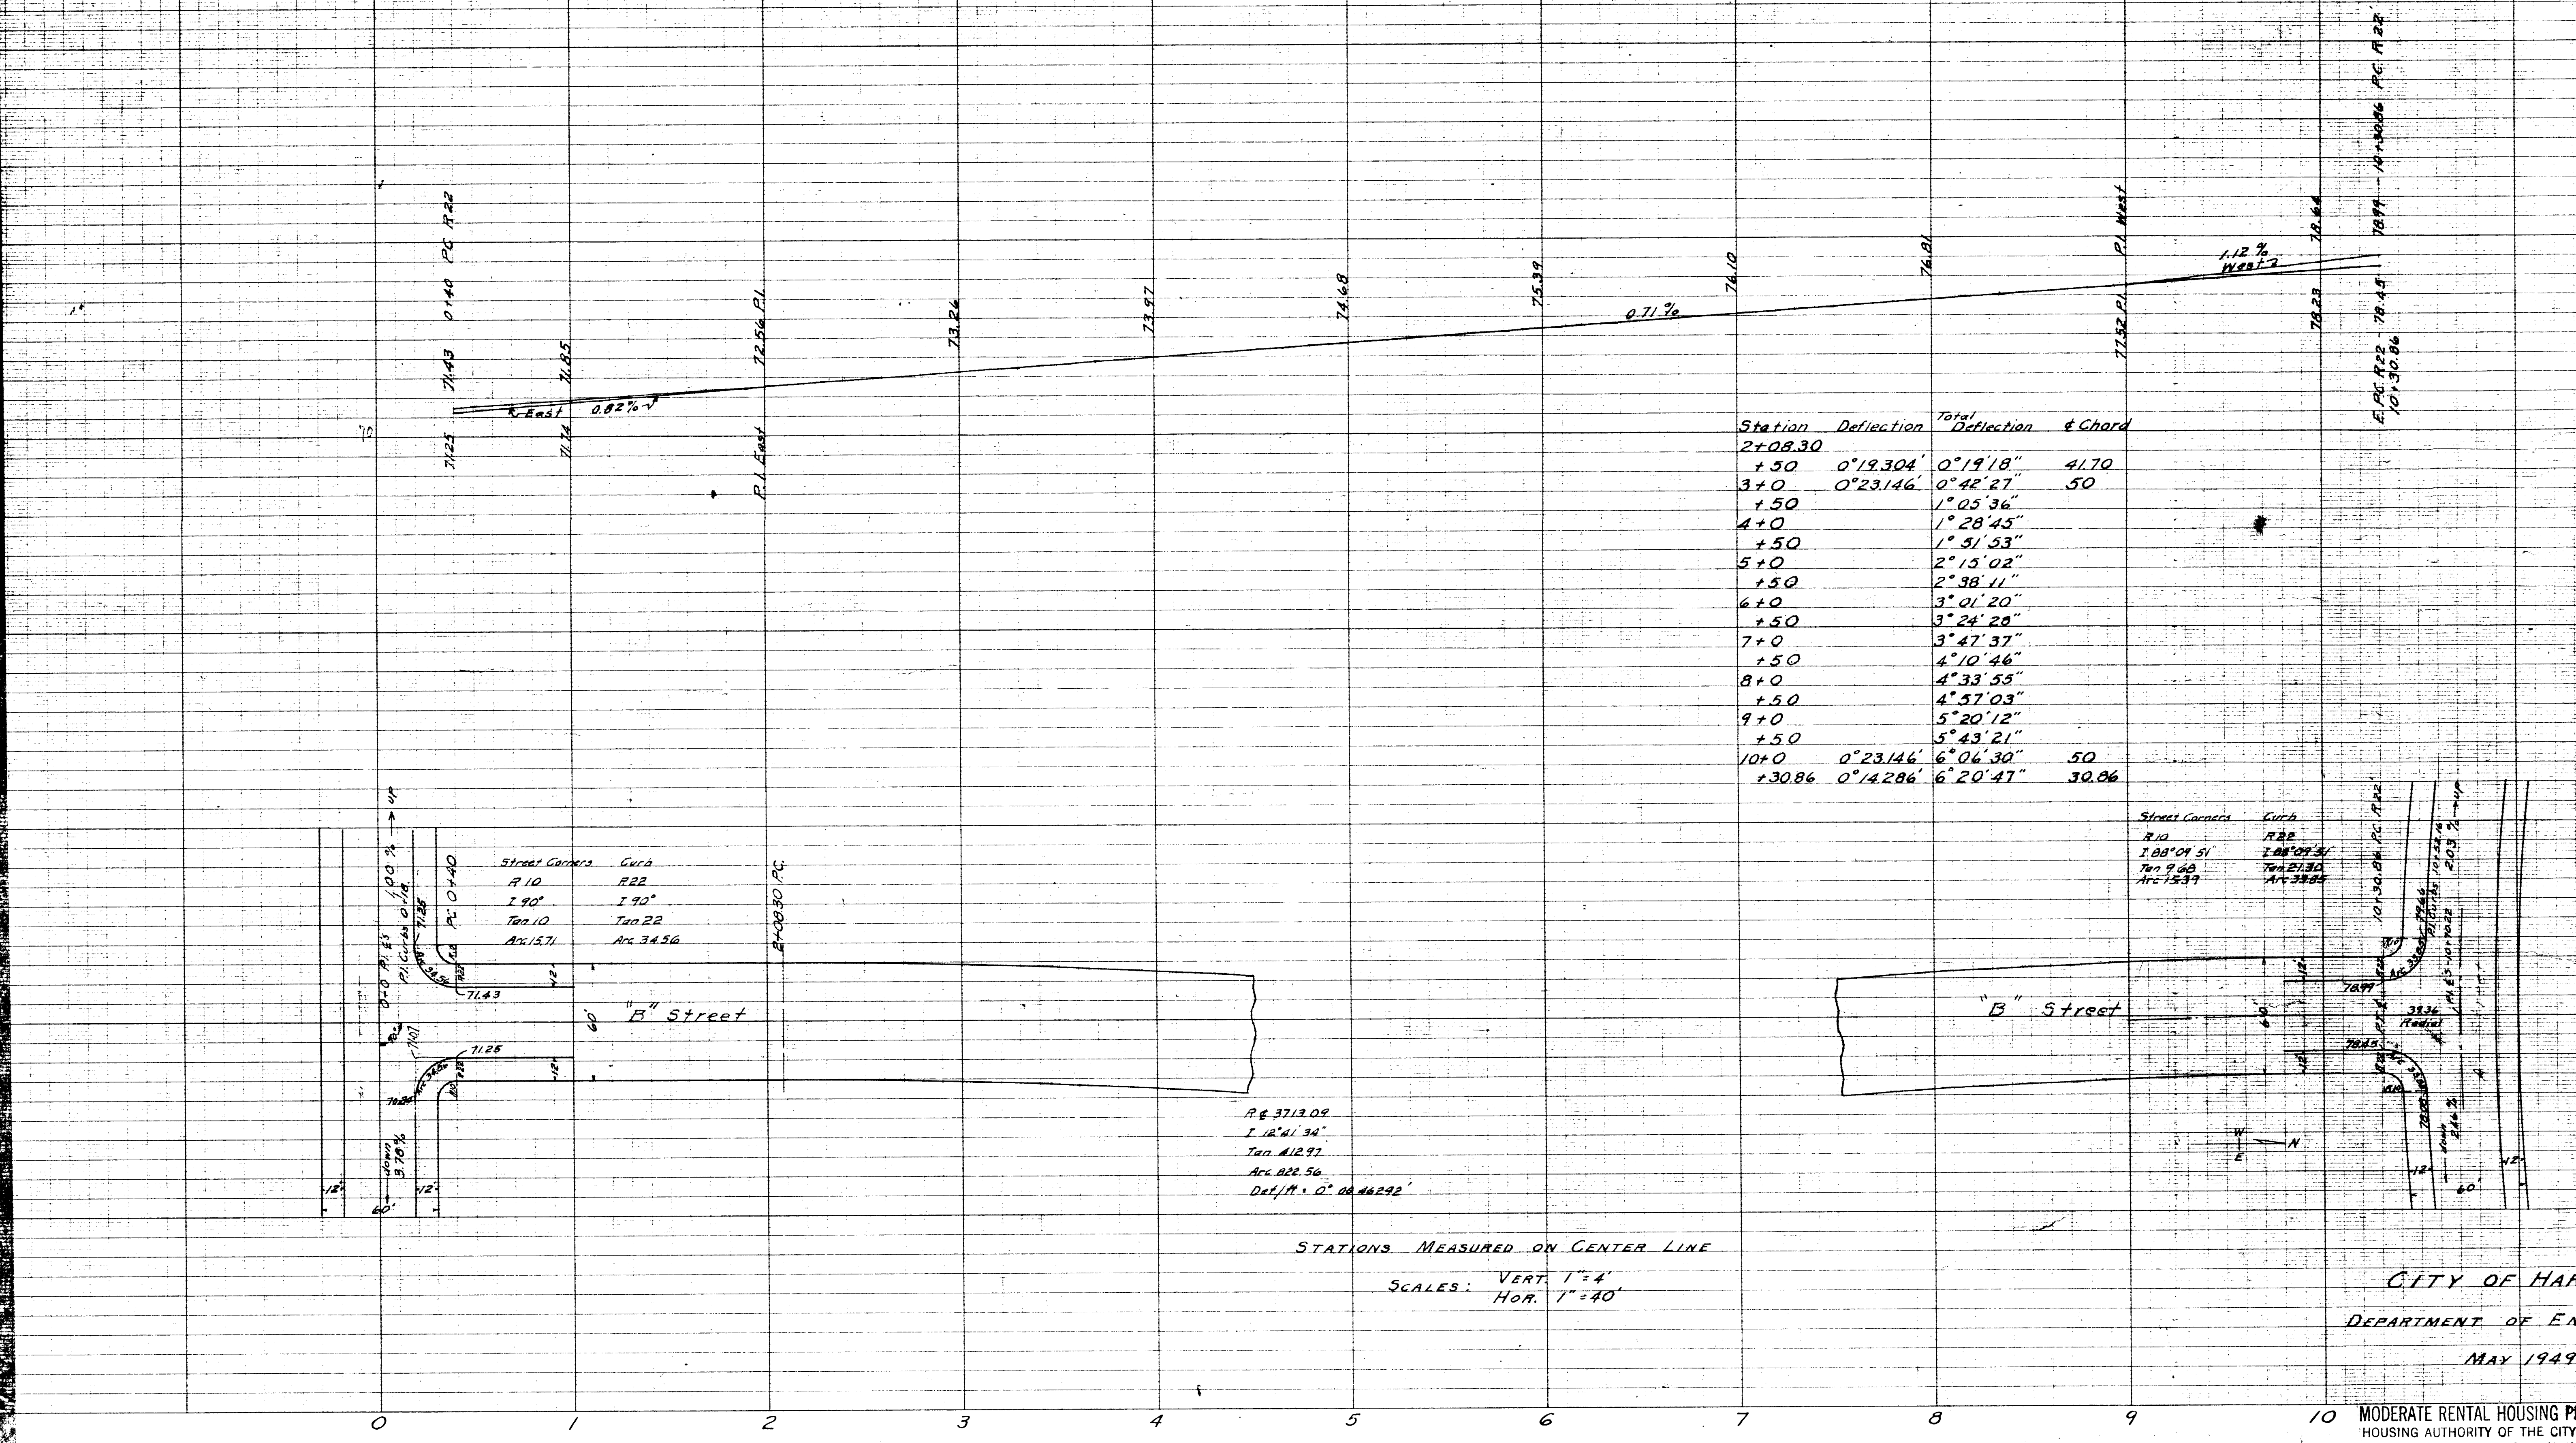
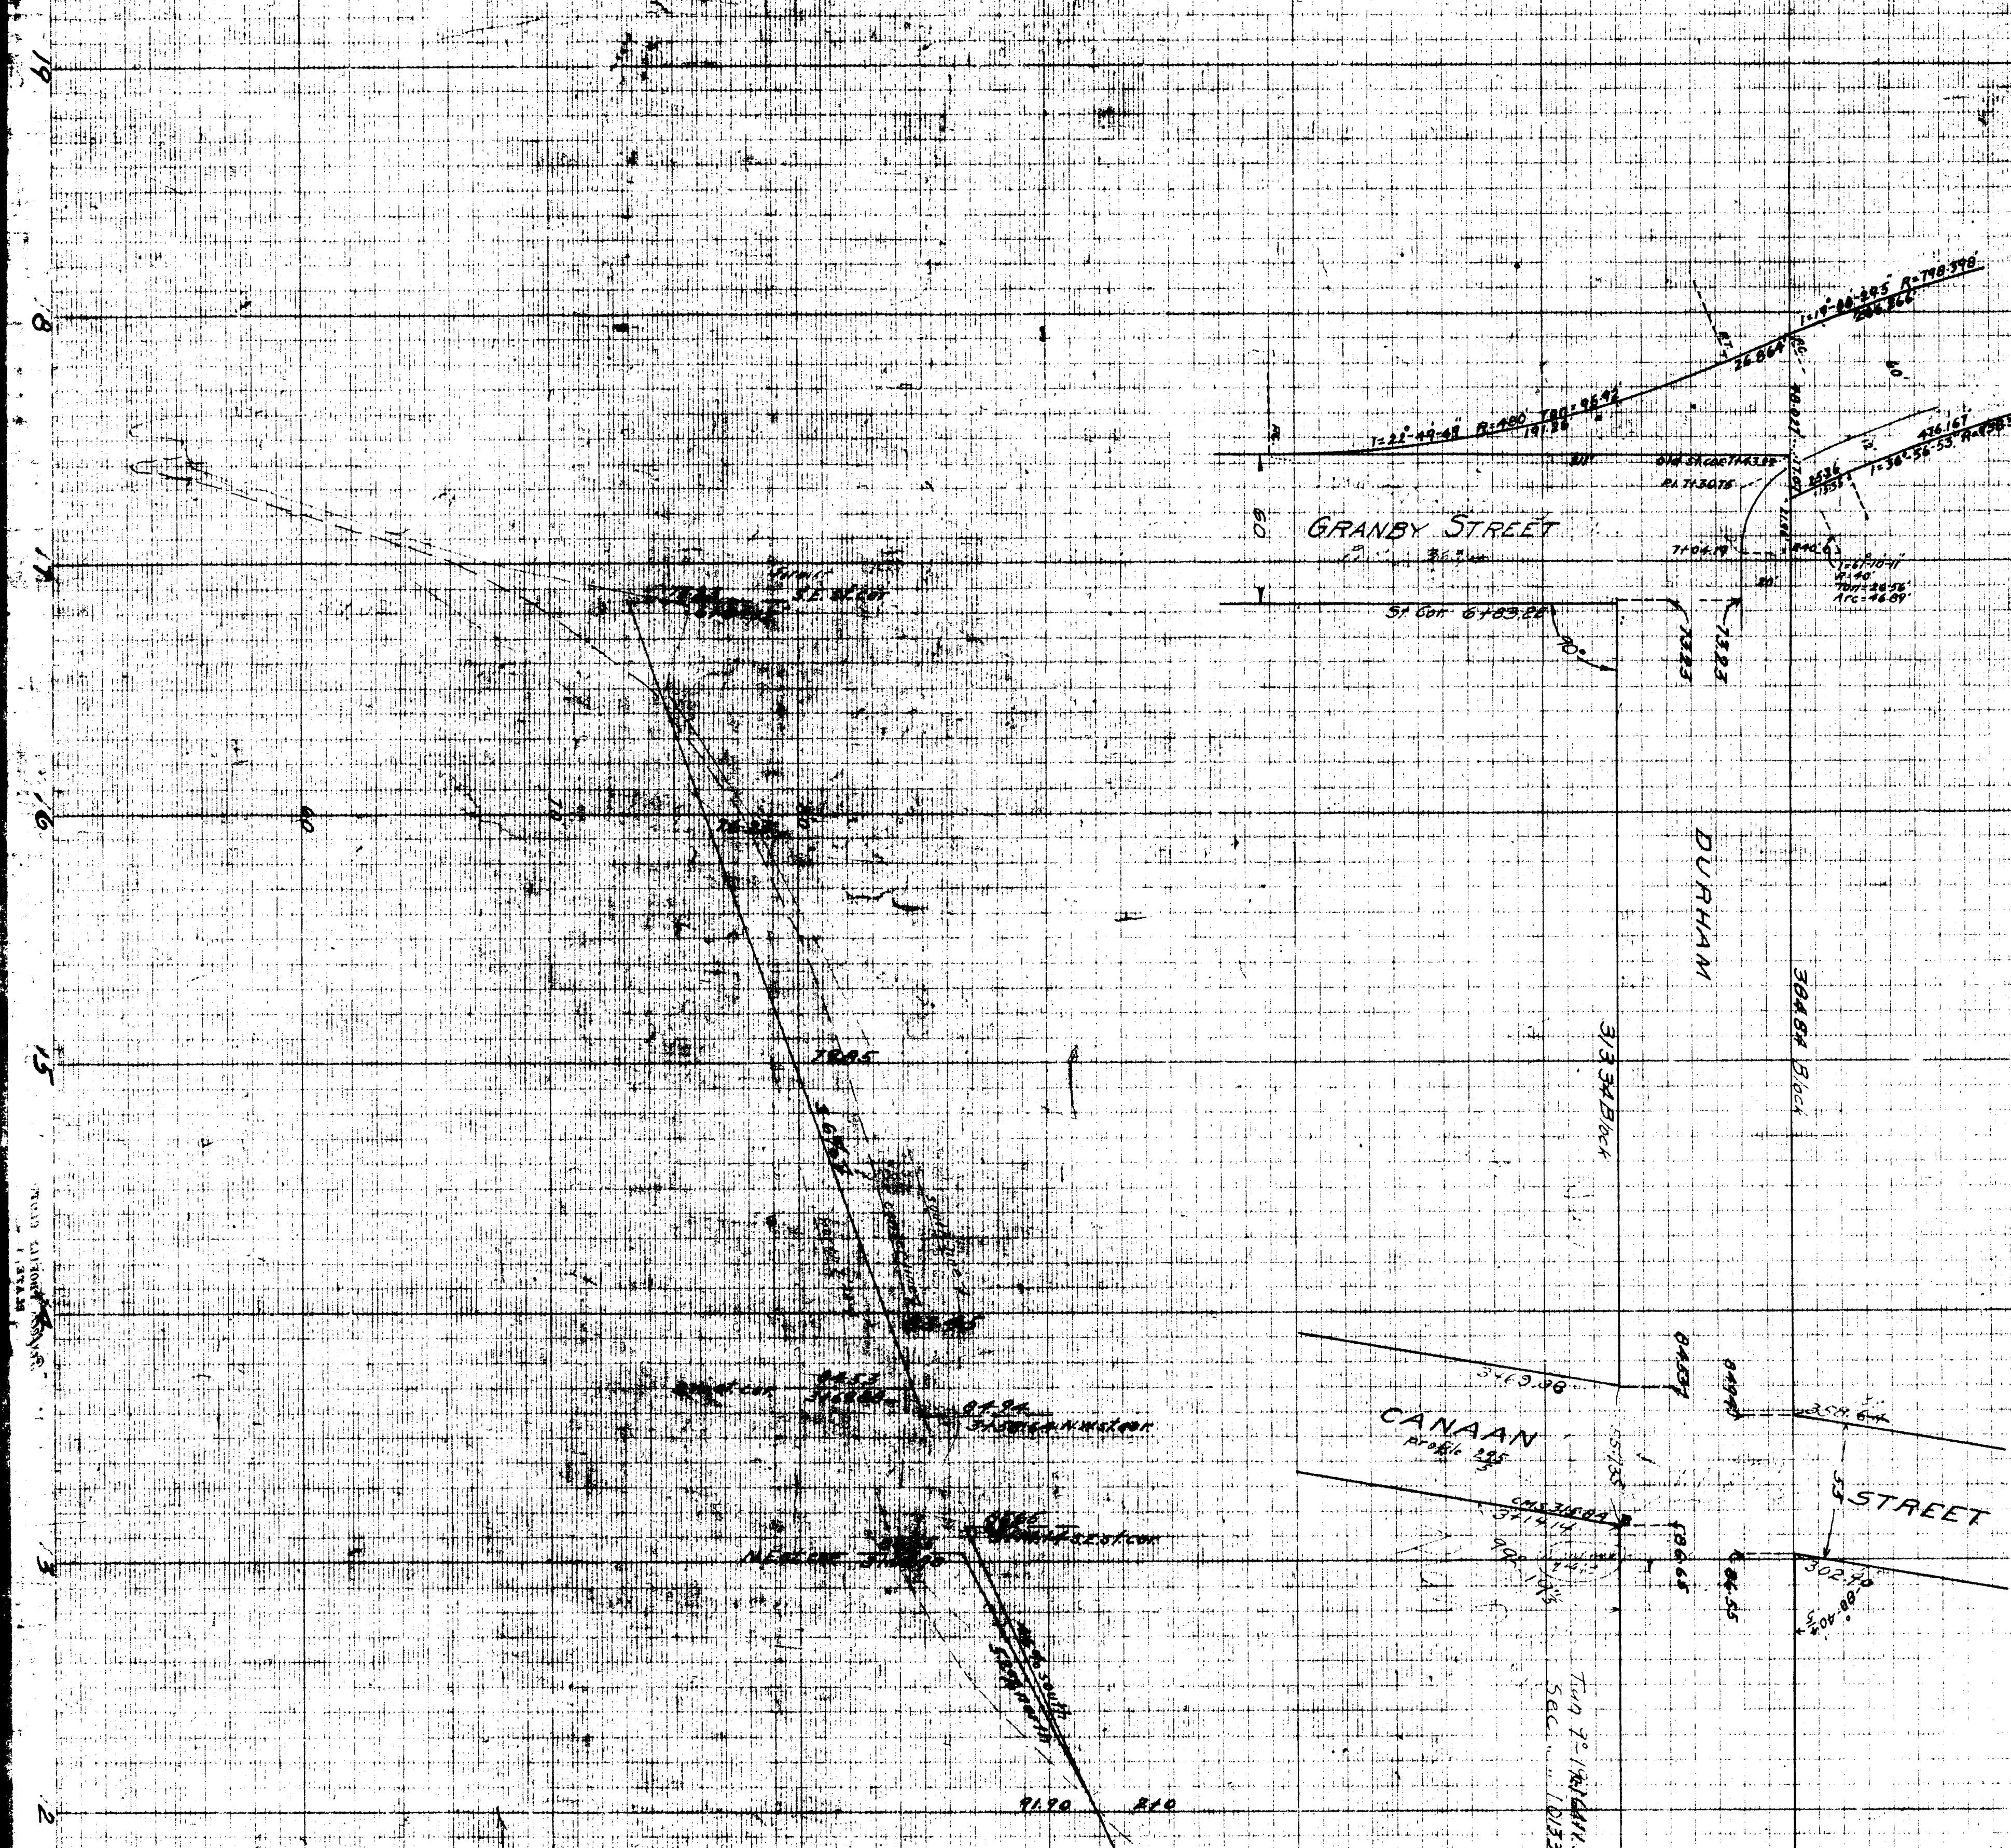


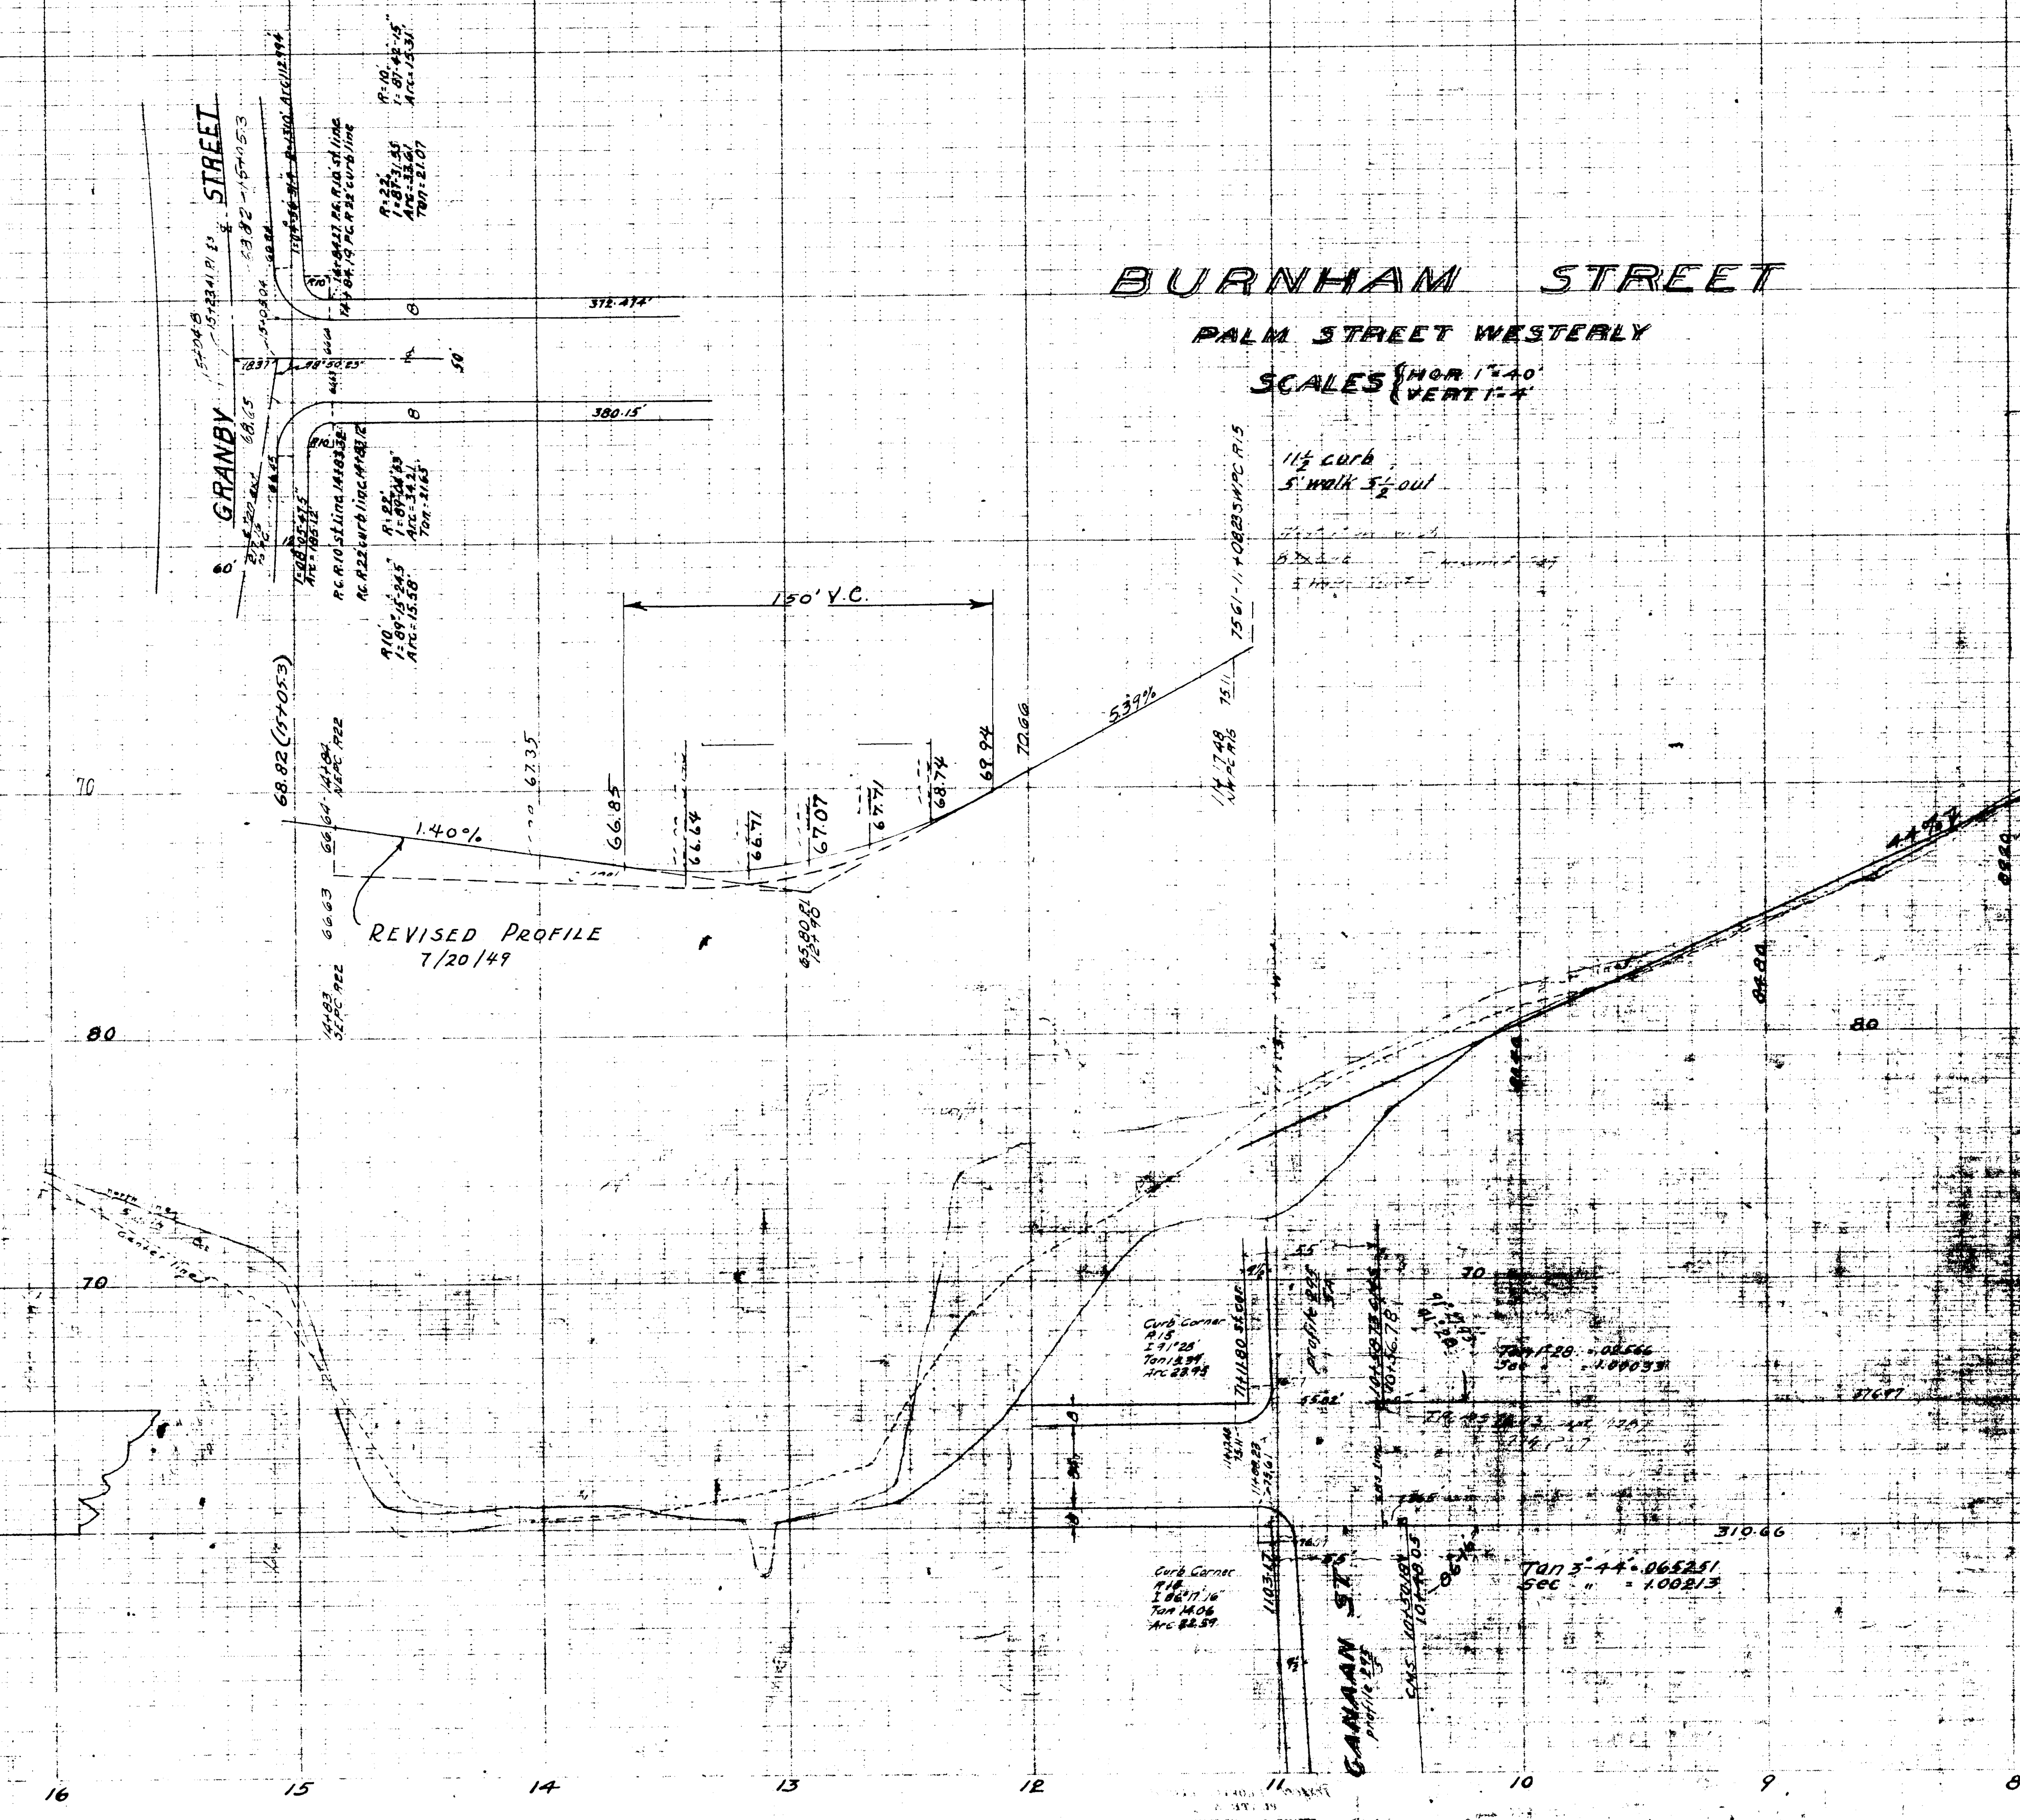

Station	Deflection	Total Deflection	Chord
2+08.30			
3+0	0°19'30"	0°19'18"	41.70
4+0	0°23'14"	0°42'32"	50
5+0		1°05'36"	
6+0		1°28'45"	
7+0		1°51'53"	
8+0		2°15'02"	
9+0		2°38'11"	
10+0		3°01'20"	
11+0		3°24'28"	
12+0		3°47'37"	
13+0		4°10'46"	
14+0		4°33'55"	
15+0		4°57'03"	
16+0		5°20'12"	
17+0		5°43'21"	
18+0	0°23'14"	6°06'30"	50
19+0	0°14'28"	6°20'47"	30.06

CITY OF HARTFORD
DEPARTMENT OF ENGINEERING
MAY 1949

MODERATE RENTAL HOUSING PROJECT MR-17
HOUSING AUTHORITY OF THE CITY OF HARTFORD
Granby Street at Burnham St., Hartford, Connecticut
S-11R