
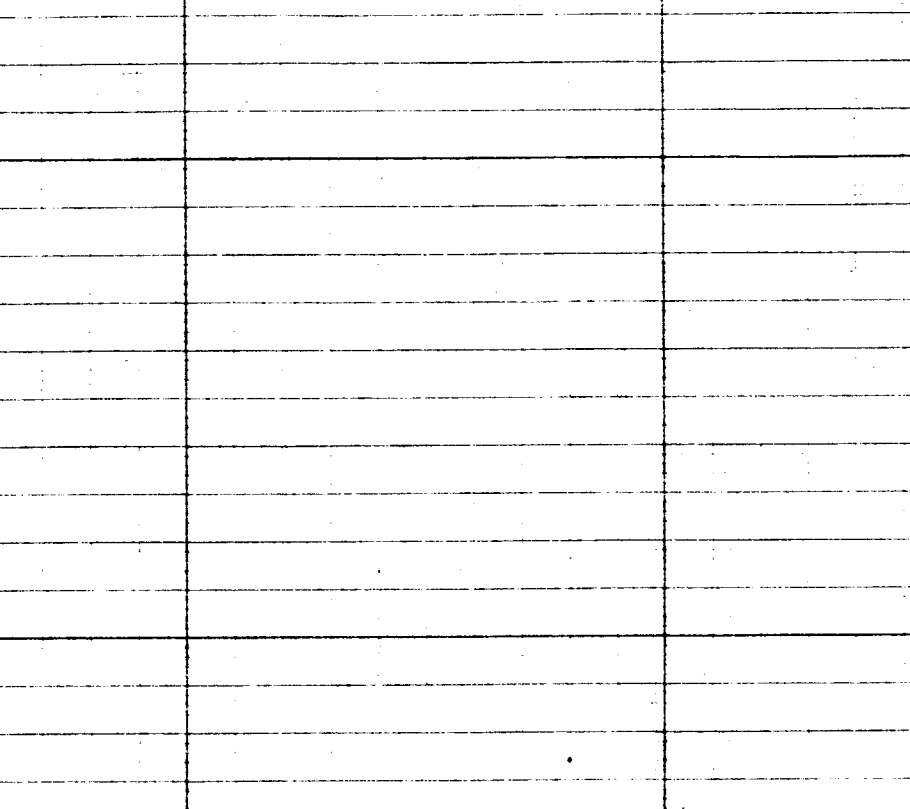
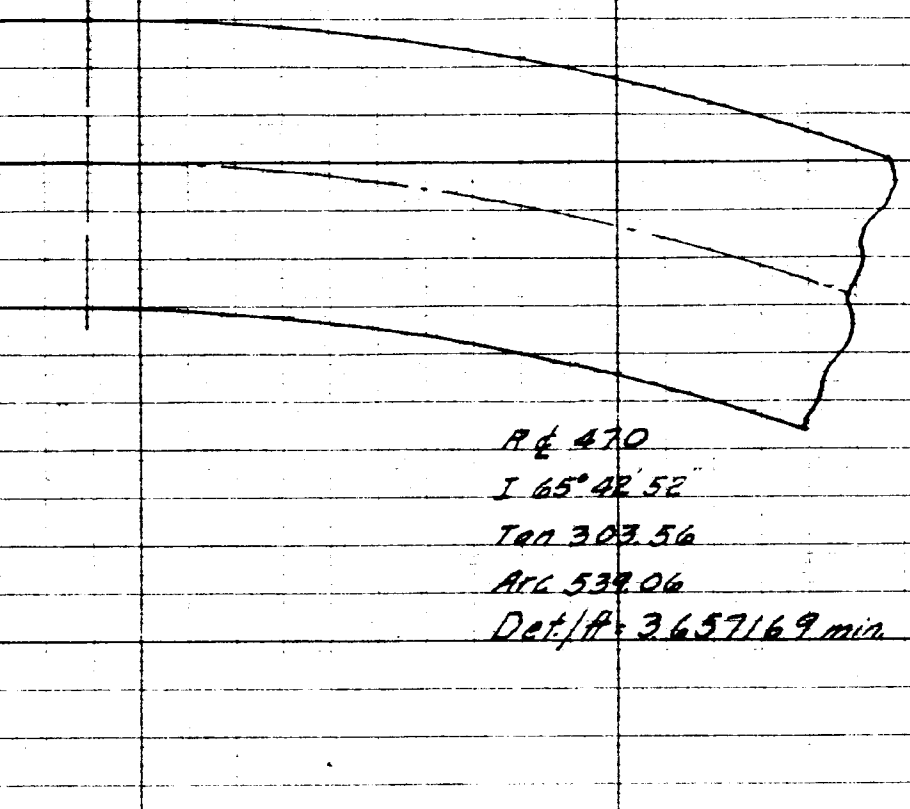
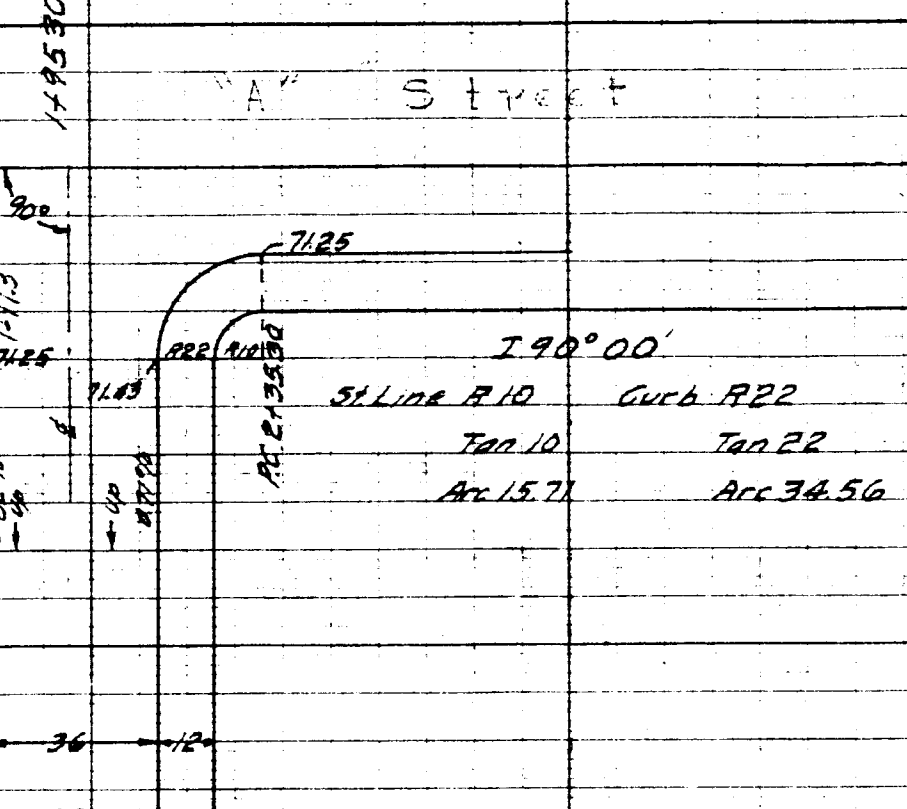
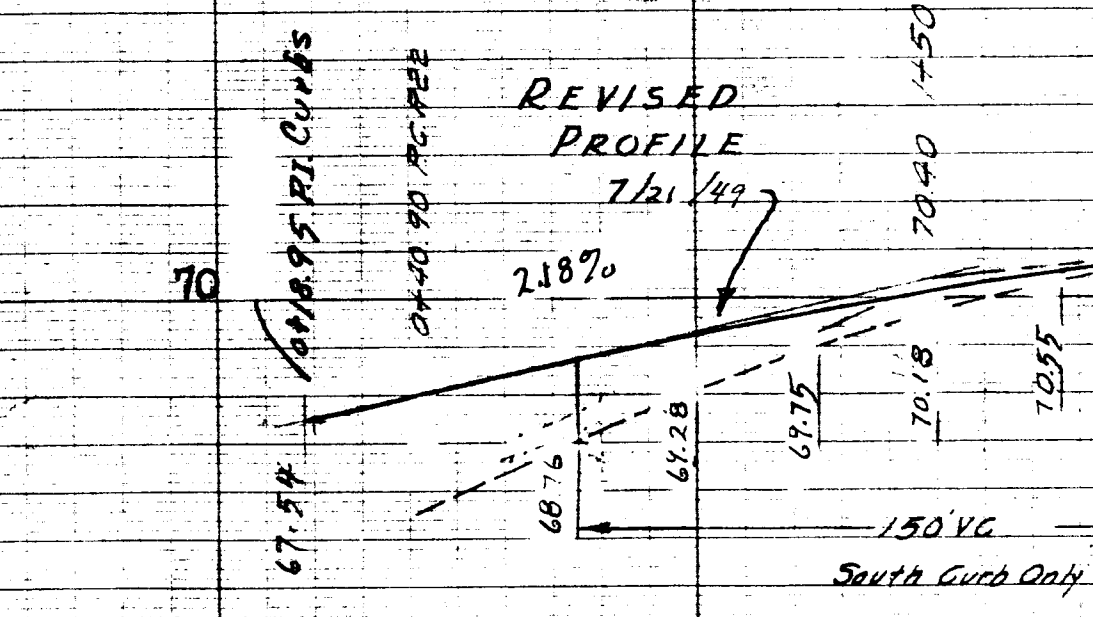


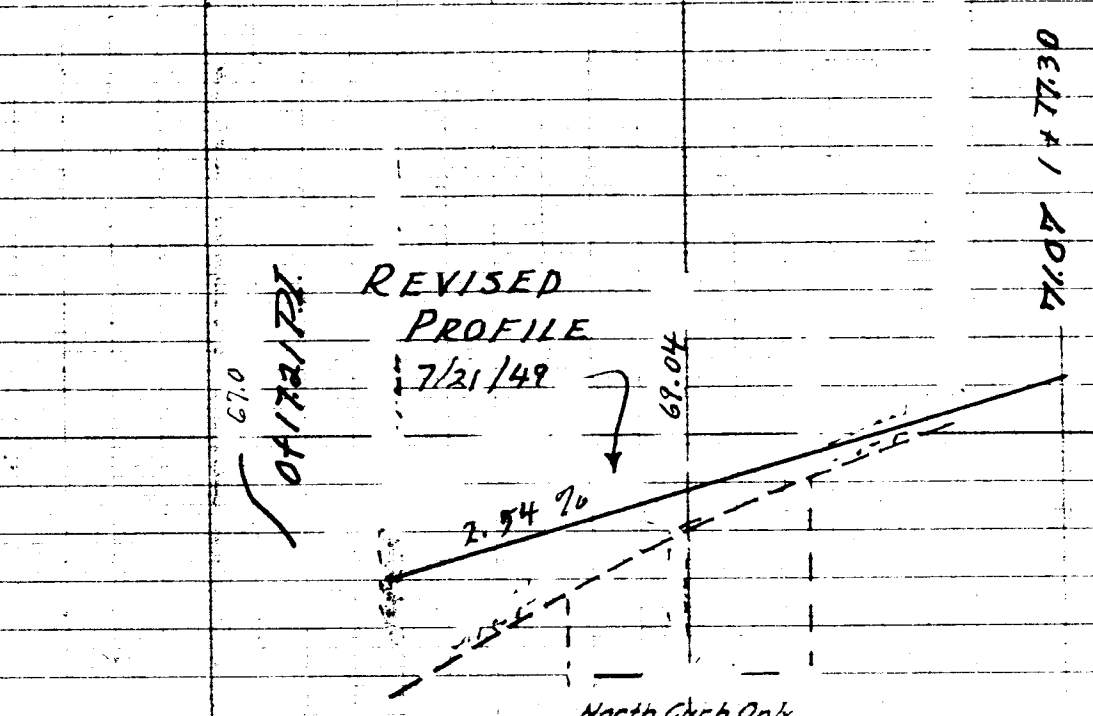









CITY OF HARTFORD
DEPARTMENT OF ENGINEERING
MAY 1989