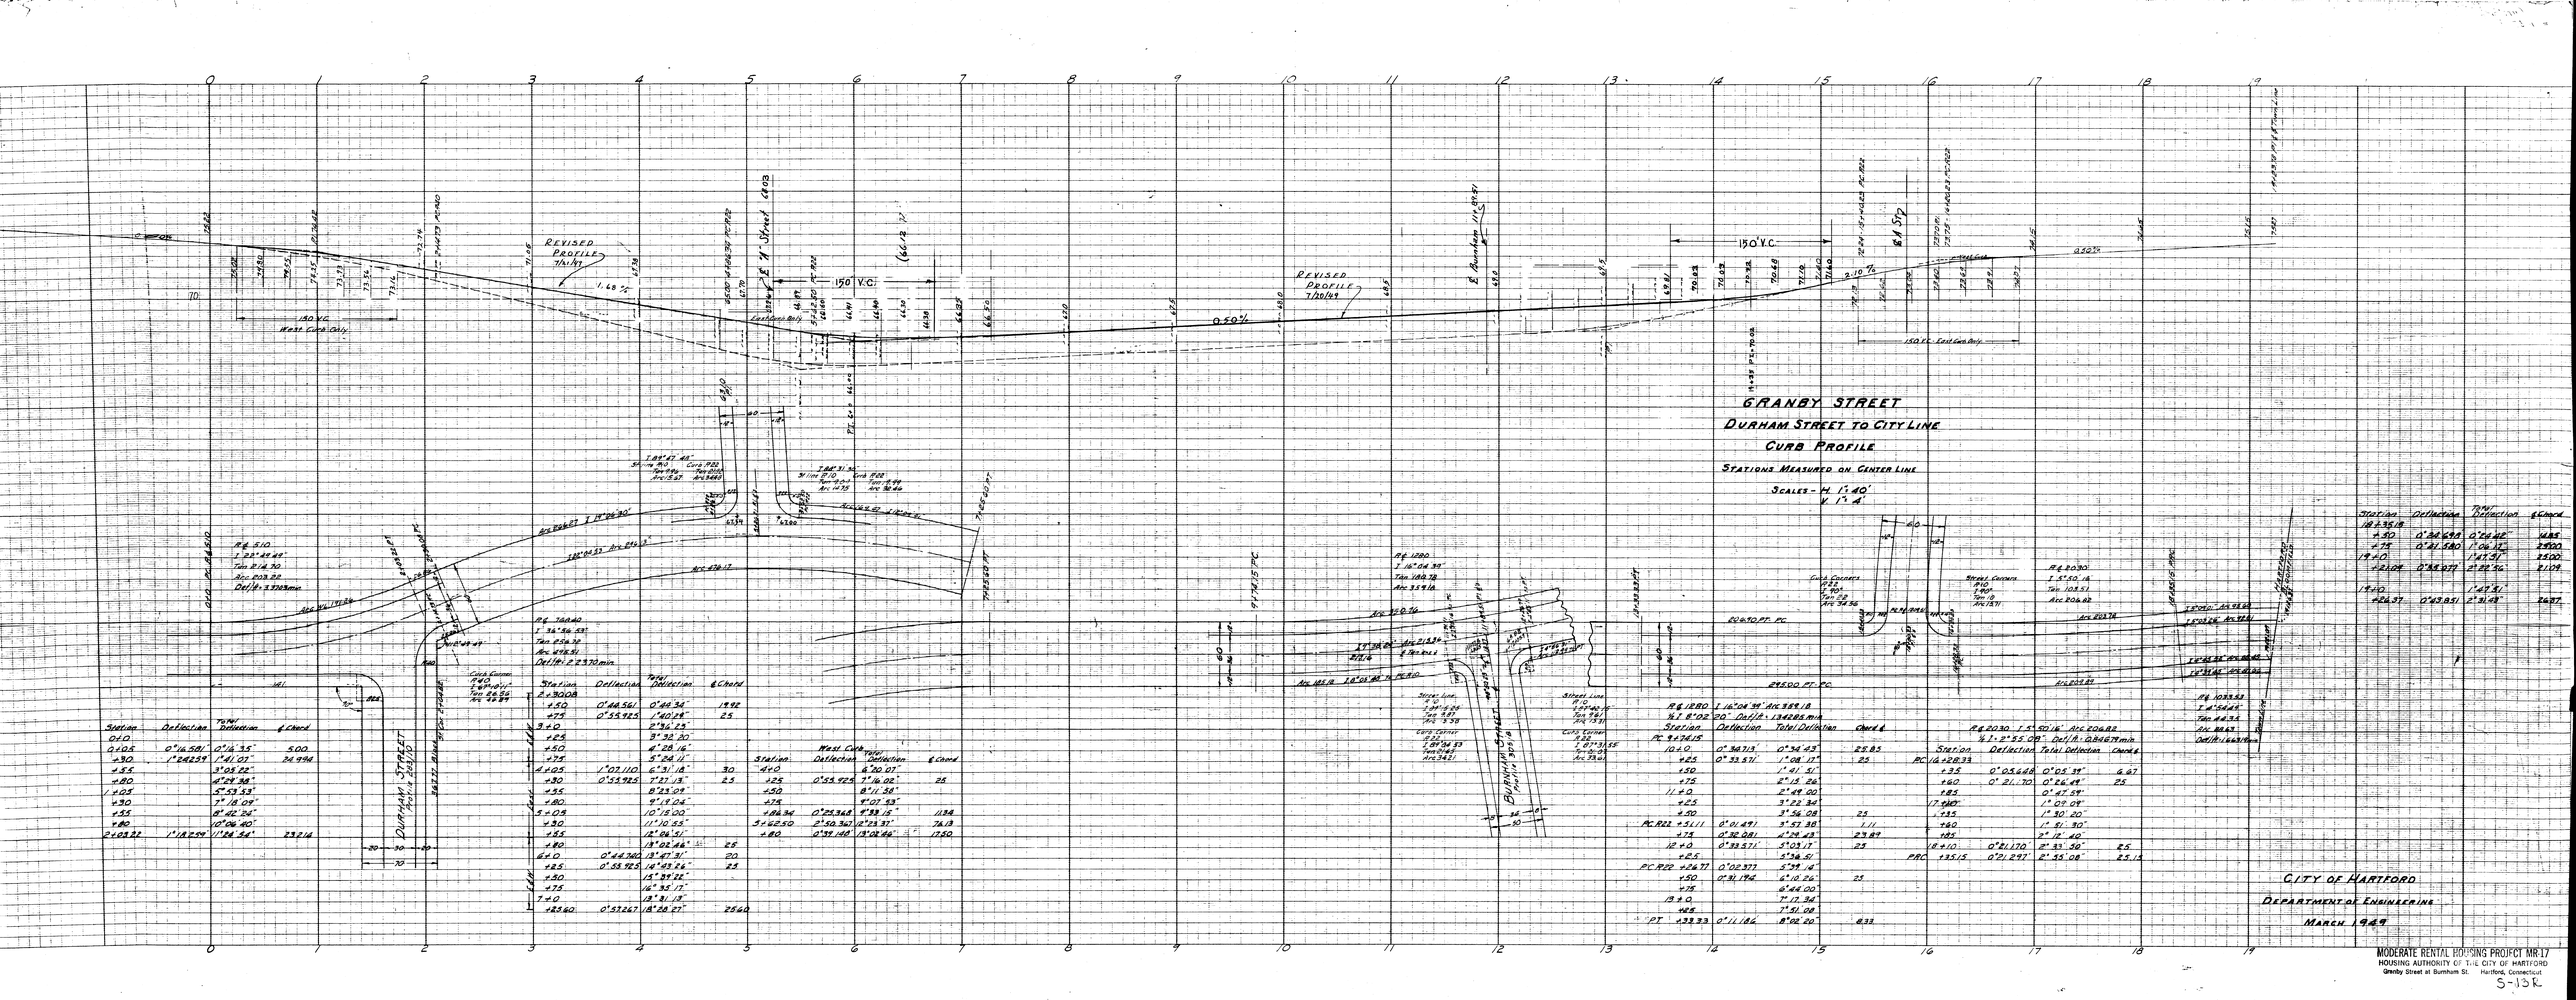
GRANBY STREET
DURHAM STREET TO CITY LINE
CURB PROFILE
STATIONS MEASURED ON CENTER LINE
SCALES - H. 1"=40'
V. 1"=4'
REVISED PROFILE 7/21/49
REVISED PROFILE 7/20/49
150 V.C.
0.50%
2.10%
1.68%
0.52%
E. Dunham 11"=89.91'
Granby Street
Durham Street
Burnham Street
