


RECEIVED BY
W. M. Carey
SEP 27 12 13 PM '00
TOLSON
BARK
VOR

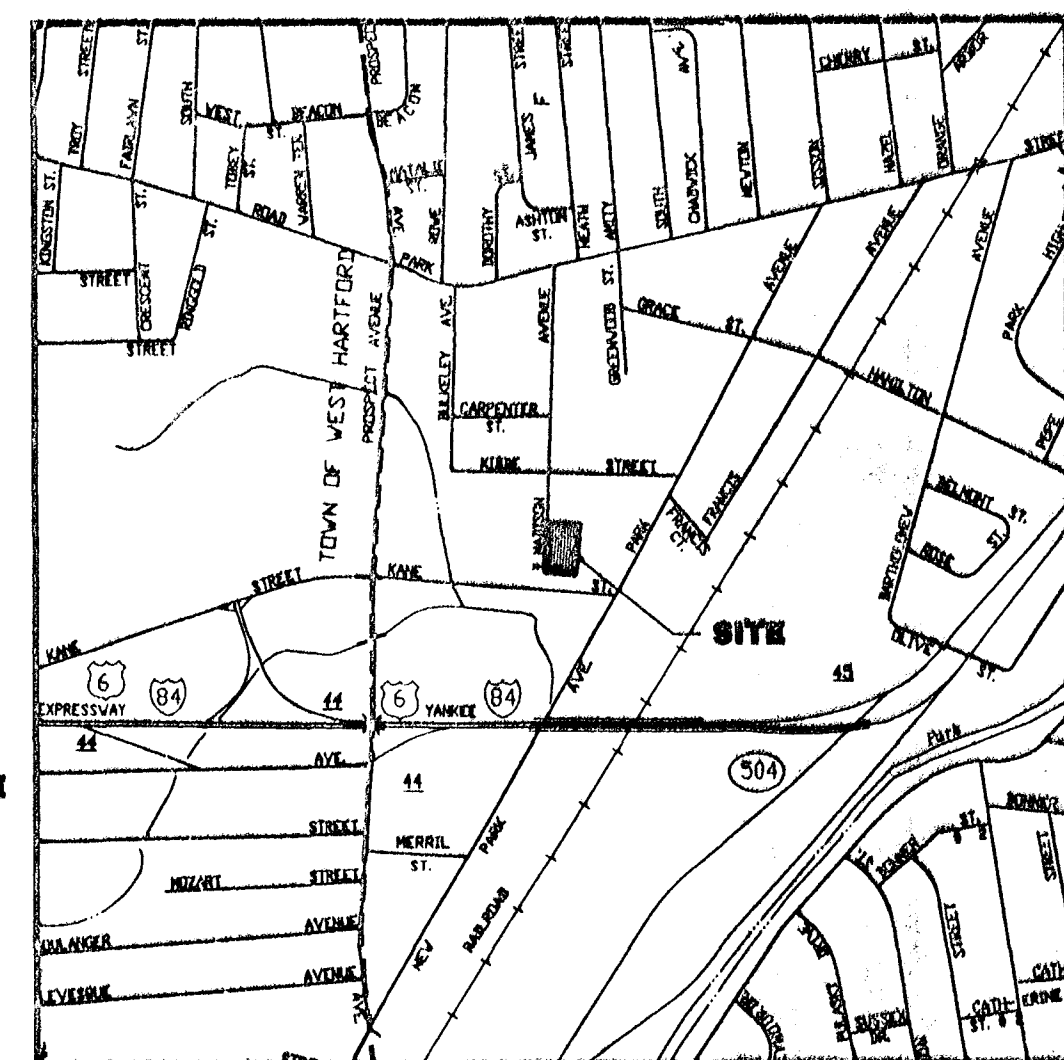

LOCATION MAP

SCALE: 1" = 1000'


SCALE: 1" = 20'	CHECKED BY: J.P.C.
DATE: SEPT. 20, 2000	DRAWN BY: B.J.H.C.
UCS No.: 829	ACAD FILE: 829-A-2
SHEET: 1	OF: 1
REVISIONS:	



HALLISEY, PEARSON & CASSIDY
CIVIL ENGINEERS & LAND SURVEYORS
78 BEAVER ROAD • WETHERSFIELD, CONNECTICUT

PROPERTY SURVEY
PREPARED FOR
OUR LADY OF FATIMA
MADISON AVENUE
HARTFORD, CONNECTICUT

The portion of the street
shown on this map is not
established public street
The City of Hartford
Print 10/2/2000
O. Blint
Survey Supervisor

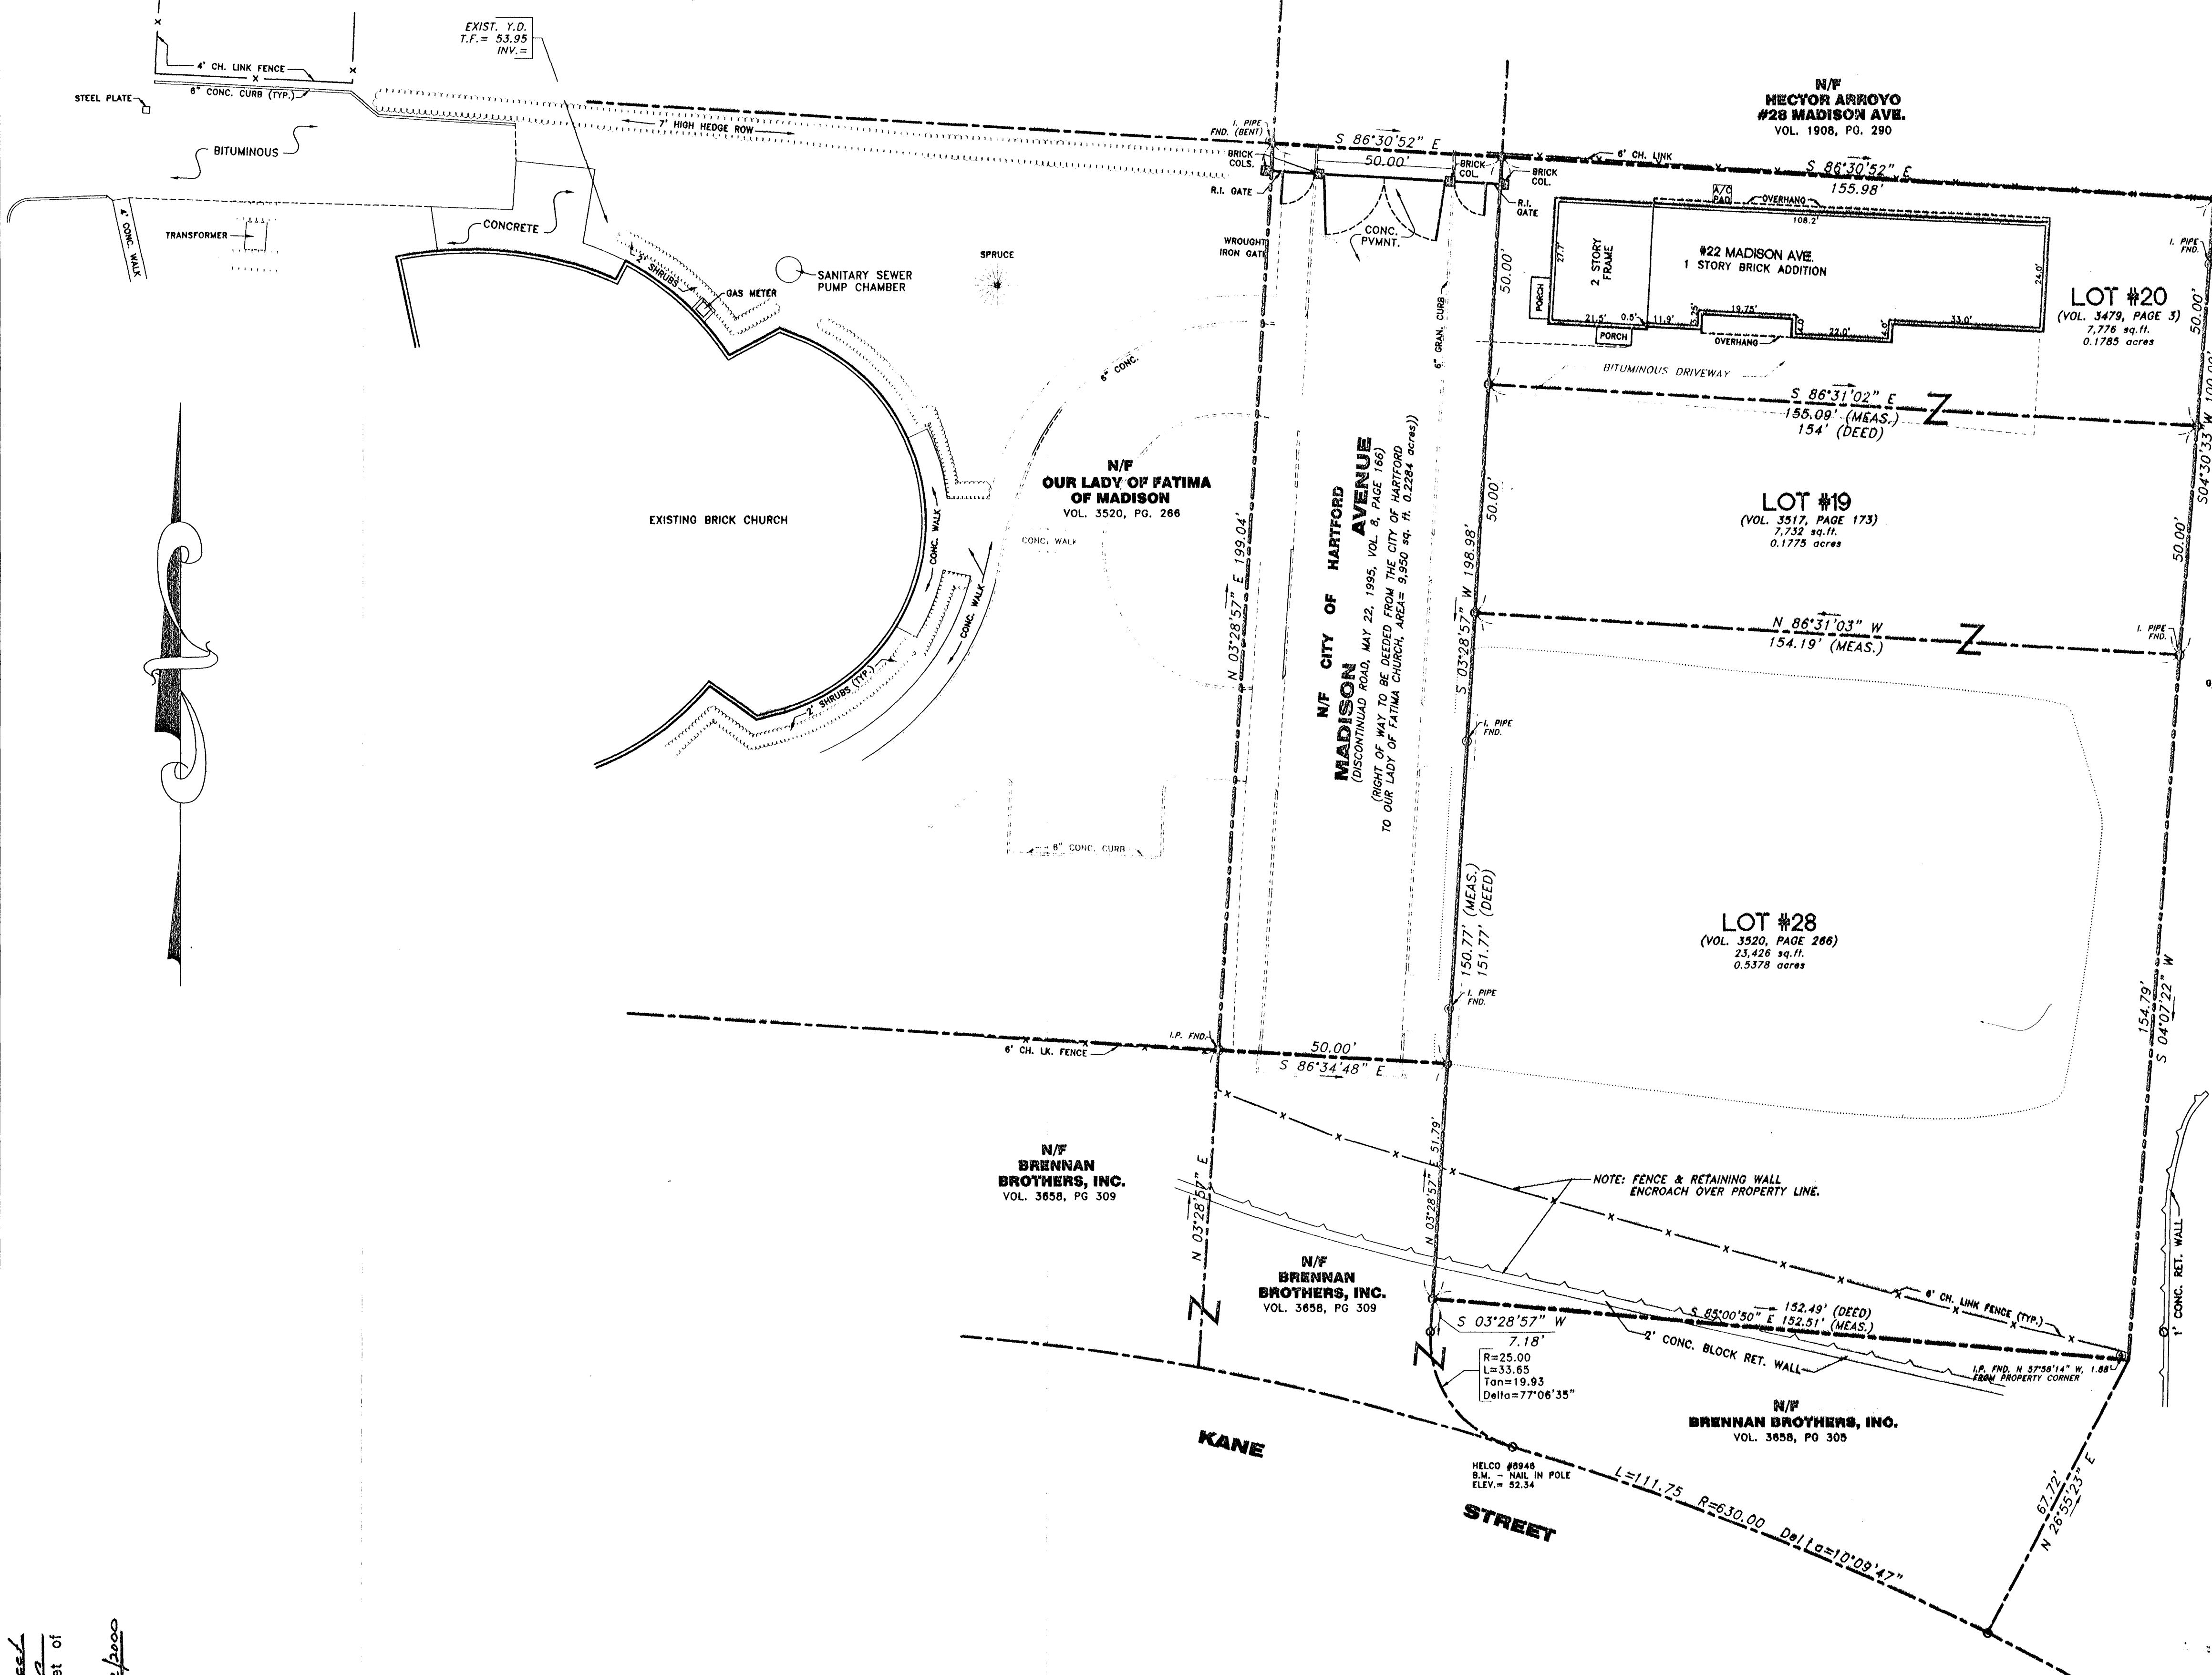

NOTES:

1. SURVEY NOTES:
- This survey has been prepared pursuant to the Regulation of Connecticut State Agencies Section 20-300b-1 Through 20-300b-20 and the "Standards for Surveys and Maps in the State of Connecticut" as adopted by the Connecticut Association of Land Surveyors, Inc. on September 28, 1996.
 - Type Of Survey Is ZONING IMPROVEMENT LOCATION SURVEY
 - Boundary Determination Category Is DEPENDENT RESURVEY
 - Class of Accuracy Is A-2
2. LOT ZONE: C-1
3. PROPERTY DOES NOT LIE IN DESIGNATED FLOOD PLAIN
4. TOTAL LOT AREA= (AS SHOWN OF PLAN)
5. MAP REFERENCES:
- a) "PLAN SHOWING LAND TO BE ACQUIRED BY THE OUR LADY OF FATIMA CHURCH, MADISON AVENUE, HARTFORD, CONNECTICUT," SCALE: 1"= 40', DATED: 6/25/94, PREPARED BY: JOHN J. LAWRENCE ASSOC.
 - b) "PROPERTY SURVEYED FOR ROBERT G. PANNAZZO, 30 KANE STREET, HARTFORD, CONNECTICUT," SCALE: 1"= 20', DATED: 10 SEPTEMBER 1986, PREPARED BY: HALLISLEY & HERBERT.
 - c) "CITY OF HARTFORD, MAP SHOWING LAND TO BE RELEASED TO AARON DUBITZKY, BY THE STATE OF CONNECTICUT, INTERSTATE ROUTE 84 (LIMITED ACCESS HIGHWAY)," SCALE: 1"= 40', DATED: JANUARY 1987, PREPARED BY: THE CITY OF HARTFORD.
 - d) "KANE STREET STREET & CURB LINE LAYOUT," SCALE: 1"= 40', DATED: MARCH 1988, PREPARED BY: THE CITY OF HARTFORD.

To the best of my knowledge and belief, this map is substantially correct as noted hereon:

Lloyd A. Pearson 9/20/00
LLOYD A. PEARSON, LS REG. NO. 17261 DATE
ON MAPS BEARING EMBOSSED SURVEYOR'S SEAL

VALID ONLY ON MAPS BEARING EMBOSSED SURVEYOR'S SEAL